

GW 12648

YAZOO  
V 44  
1/78  
EW # 276

MISSISSIPPI  
BOARD OF WATER COMMISSIONERS  
416 North State Street  
Jackson, Mississippi 39201

CODED

WATER WELL DRILLERS LOG

JAN. 1978 CRIVER DRILLING SER. YAZOO  
date well completed firm name county well located

LANDOWNER: CENTRA YAZOO  
WATER ASSOC. ~~WATER~~  
SOUTH WELL  
(mailing address)

WELL LOCATION: SW 1/4 NE 1/4 NW 1/4  
sec. 15 T 9 N R 3 E  
S W

WELL PURPOSE:  
(home, irrigation, municipal, industrial)

- WELL COMPLETION DATA:
- (1) diameter (inches) 10 3/4
  - (2) total depth (feet) 1582
  - (3) static water level (feet) 268 below above top of ground.
  - (4) casing steel, 1512,  
(material) (depth)  
10 3/4 If telescope see back.  
(size)
  - (5) screen 50, 1532  
(length) (depth to top)  
6, 304 S.S. (10/10)  
(size) (material)
  - (6) pump 40, 250  
(HP) (yield gpm)  
Elect.  
(type power)
  - (7) electric log YES  
(yes or no)  
Miss. Geol. Survey  
(organization running log)
  - (8) how well bottom plugged BACK  
WASH VALUE

description of formations encountered	from to	
Top soil	0	3
Silty CLAY (Loess)	3	38
CLAY	38	65
SAND	65	143
CLAY	143	560
SAND	560	610
CLAY (SANDY)	610	639
SAND	639	700
SANDY CLAY	700	870
SAND	870	908
CLAY	908	1160
SAND	1160	1210
CLAY	1210	1490
SAND	1490	1586
CLAY w/ SAND streaks	1586	1630
SAND	1630	1670


RECEIVED  
JAN 30 1978

MISS. BD. OF WATER CUSTODY

DRILLERS REMARKS:

If well telescopes please sketch and show depths.

GROUND LEVEL

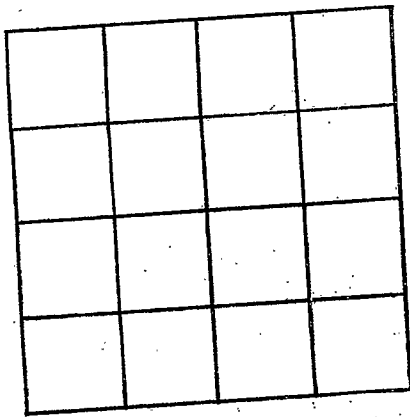

SECTION \_\_\_\_\_

Please indicate well location X.

ADDITIONAL INFORMATION

A series of horizontal lines for writing additional information, starting below the 'ADDITIONAL INFORMATION' header and extending to the bottom of the page.

If more than one screen, show locations of each on sketch.