

MISSISSIPPI DEPARTMENT OF NATURAL RESOURCES
Bureau of Land and Water Resources
 Southport Mall
 P.O. Box 10631
 Jackson, Mississippi 39209
WATER WELL DRILLERS LOG

CODED

YA200
V50
9/21/81

21 Sept 1981 J.L. Gatz Explorations YA200
 date well completed firm name county well located

LANDOWNER:	description of formations encountered	from	to
<u>Ollie Ellis</u> <u>1516 Everett</u> <u>Jackson Ms</u> (mailing address)			
WELL LOCATION:			
sec. <u>17</u> T. <u>8</u> S. R. <u>3</u> E. <u>W</u>			
<u>6</u> miles <u>East</u> of <u>Phoenix</u> (distance) (direction) (nearest town)			
WELL PURPOSE:			
<u>Home</u> (home, irrigation, municipal, industrial)			
WELL COMPLETION DATA:			
(1) diameter (inches) <u>6 3/4</u>			
(2) total depth (feet) <u>200</u>			
(3) static water level (feet) <u>52</u> below top of ground.			
(4) casing <u>PVC</u> <u>172</u> (material) (depth)			
<u>4</u> (size) If telescope see back.			
(5) screen <u>20</u> <u>172</u> (length) (depth to top)			
<u>4</u> <u>PVC</u> (size) (material)			
(6) pump <u>1</u> <u>120</u> (HP) (yield gpm)			
<u>220 Elec</u> (type power)			
(7) electric log <u>Yes</u> (yes or no)			
<u>Bureau of Geology</u> (organization running log)			
(8) how well bottom plugged <u>Valves</u>			
DRILLERS REMARKS:			


CODED

DEPT. OF NATURAL RESOURCES
 BUREAU OF LAND & WATER RESOURCES

RECEIVED
 MAY 17 1982

If well telescopes please sketch and show depths.

GROUND LEVEL

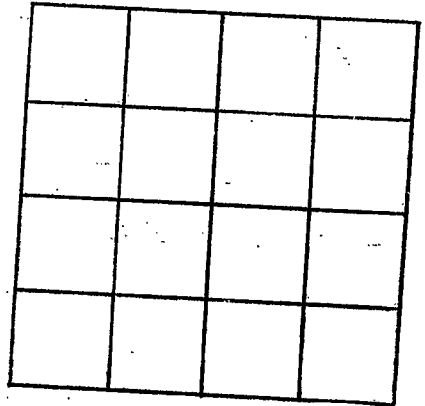

SECTION _____

Please indicate well location X.

ADDITIONAL INFORMATION

A series of horizontal lines providing space for additional information.

If more than one screen, show locations of each on sketch.