

MISSISSIPPI DEPARTMENT OF NATURAL RESOURCES

Bureau of Land and Water Resources

Southport Mall

P.O. Box 10631

Jackson, Mississippi 39209

WATER WELL DRILLERS LOG

CODED

Griner Drilling Service, Inc.

Yazoo

YAZOO
V51
2/5/82

2-5-82 date well completed

Griner Drilling Service, Inc. firm name

Yazoo county well located

LANDOWNER:
New & Hughes
P.O. Drawer 1487
Natchez, ms 39120
(mailing address)

description of formations encountered	from	to
chalk-large gravel	0	21
chalk	21	315
streaked	315	389
sand	389	452
chalk	452	546

WELL LOCATION: 1479'W & 1420'E

No. 1 sec. 4 T. 9 N. R. 3 E. of Henderson Hancock Mechanicsburg (distance) (direction) (nearest town)

WELL PURPOSE: oil field supply (home, irrigation, municipal, industrial)

WELL COMPLETION DATA:

- (1) diameter (inches) 3"
- (2) total depth (feet) 546'
- (3) static water level (feet) 80' below top of ground.
- (4) casing steel 441' (material) (depth)
- 3" (size) If telescope see back.
- (5) screen 42' 399' (length) (depth to top)
- 3" perforated (size) (material)
- (6) pump - 70 (HP) (yield gpm)
- AC (type power)
- (7) electric log - (yes or no)
- (organization running log)

CODED

DEPT. OF NATURAL RESOURCES BUREAU OF LAND & WATER RESOURCES

FEB 10 1982


RECEIVED

(8) how well bottom plugged orange peel

DRILLERS REMARKS:

If well telescopes please sketch and show depths.

GROUND LEVEL

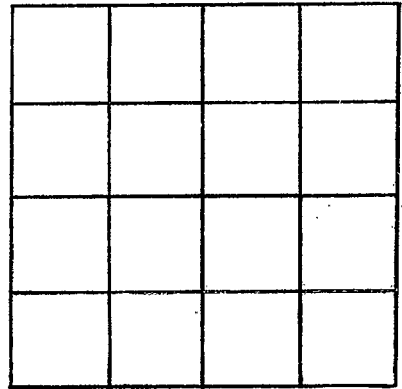

SECTION _____

Please indicate well location X.

ADDITIONAL INFORMATION

If more than one screen, show locations of each on sketch.