

MISSISSIPPI DEPARTMENT OF NATURAL RESOURCES

Bureau of Land and Water Resources

Southport Mall

P.O. Box 10631

CODED

Jackson, Mississippi 39209

WATER WELL DRILLERS LOG

Griner Drilling Service, Inc.

1/2200

V53  
1/2200  
12-20-84

12-20-84  
date well completed

firm name

county well located


LANDOWNER:	description of formations encountered	from	to
(mailing address)			
Marion Drilling P.O. Box 3027 Daphne, Ala. 36526	streaked	0	84
WELL LOCATION: 2400' S 1500' E sec. 17 T. 9 N. R. 3 E of No. 1 H.A. Ryan Benton, Miss. (nearest town)	CLAY	84	588
WELL PURPOSE: oil field supply (home, irrigation, municipal, industrial)	SAND	588	598
WELL COMPLETION DATA:	streaked	598	756
(1) diameter (inches) 3"	CLAY	756	1315
(2) total depth (feet) 1386'	SAND	1315	1386
(3) static water level (feet) 150' below top of ground.			
(4) casing steel 1386' (material), (depth) 3" (size) if telescope see back.			
(5) screen 63 1323' (length), (depth to top) 3" perforated (size), (material)			
(6) pump - 75 (HP), (yield gpm) AC (type power)			
(7) electric log (yes or no) Bureau of Geology (organization running log)			
(8) how well bottom plugged orange peel			
DRILLERS REMARKS:			

CODED

Permit # 17-85

If well telescopes please  
sketch and show depths.

GROUND LEVEL

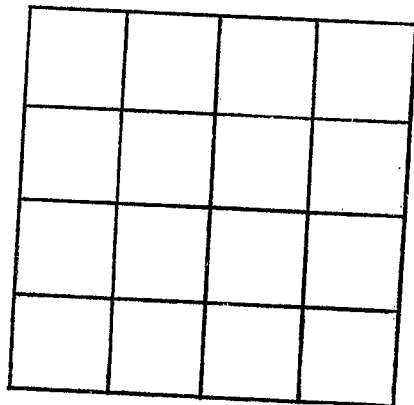

SECTION \_\_\_\_\_

Please indicate well location X.

ADDITIONAL INFORMATION

If more than one screen,  
show locations of each on sketch.