

MISSISSIPPI DEPARTMENT OF NATURAL RESOURCES

Bureau of Land and Water Resources

Southport Mall

P.O. Box 10631

Jackson, Mississippi 39209

WATER WELL DRILLERS LOG

CODED

Griner Drilling Service, Inc.

Yazoo

V55  
YAZOO  
4-15-85

4-15-85  
date well completed

Griner Drilling Service, Inc.  
firm name

Yazoo  
county well located

LANDOWNER:

Home Petroleum Corp  
70 Marion Drilling  
P.O. Box 3027

Daphne, Ala address 36616

WELL LOCATION: 2080' N + 1500' E

description of formations encountered

from to

clay

0 538

streaked

538 672

SAND

672 714

clay

714 735

CODED

No. 1 sec. 17 T. 9 N R. 3 E of

X.H.A. Bentonina of

Ryan et al (distance) (direction) (nearest town)

WELL PURPOSE: oilfield supply  
(home, irrigation, municipal, industrial)

WELL COMPLETION DATA:

- (1) diameter (inches) 3"
- (2) total depth (feet) 735'
- (3) static water level (feet) 150' below above top of ground.
- (4) casing steel 714'  
(material) (depth)  
3"  
(size) if telescope see back.
- (5) screen 84" 630'  
(length) (depth to top)  
3" perforated  
(size) (material)
- (6) pump — 75  
(HP) (yield gpm)  
AC  
(type power)
- (7) electric log (yes or no)

(organization running log)

(8) how well bottom plugged orange  
peel


DRILLERS REMARKS:

RECEIVED  
APR 18 1985

Department of Natural Resources  
Bureau of Land & Water Resources

If well telescopes please  
sketch and show depths.

GROUND LEVEL

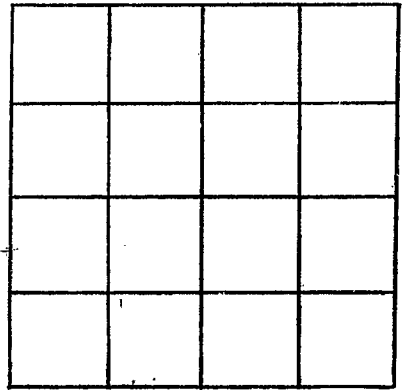

SECTION \_\_\_\_\_

Please indicate well location X.

ADDITIONAL INFORMATION

If more than one screen,  
show locations of each on sketch.