

TFU 15-6 + TFU 25-1 #2

State Well Report

Part 1

Mississippi Department of Environmental Quality
Office of Land and Water Resources
P.O. Box 10631
Jackson, MS 39289-0631
(601)961-5210
(601)354-6938 (fax)

For Office Use Only:

Aquifer: V04
Well #: _____
L. S. Elevation: _____
E-log #: _____

County: Yazoo
Permit #: _____
Driller: John W Thompson
Date drilling completed: 1-29-10

State Law requires that this report be prepared by the driller in detail and filed with the Department within 30 days of completion of drilling of the well.

Well Owner Information	Well Location
Owner Name: <u>Denbury Onshore</u>	Latitude: <u>32.39.24</u> " Longitude: <u>90.27.52</u> "
Mailing Address: <u>P.O. Box 6506</u> <u>Laurel MS</u>	Method of Lat/Long (circle one): Conventional Survey, USGS quad, Hand-held GPS, Survey-grade GPS
City: _____ State: _____ Zip Code: _____	<u>SW 1/4 NW 1/4 Sec 1</u> Twn <u>9N</u> Rng <u>32W</u>
Telephone No. () _____	Distance: <u>5</u> Miles Direction: <u>SE</u> of Nearest Town: <u>Sartoria</u>

Well Data

Purpose of Well (circle one) Home Industrial Public Supply Irrigation Fish Culture Other: rig supply

Date well drilling started: 1-26-10 Date well drilling completed: 1-29-10

If flowing, method of flow regulation: Valve _____ Other (describe) _____

Static Water Level: 225 feet above or below (circle one) land surface Date measured: 1-29-10

Method of Measurement (circle one) steel tape electric tape air line other: _____

Hole depth: 803 Well depth: 700 Well grouted to a depth of 15 feet

Type of grout (circle one): Cement Bentonite Mix

Casing length: 620 feet Casing diameter: 4 inches Type of casing: PVC

Screen length: 80 feet Screen diameter: 4 inches Type of screen: PVC slotted

Screen slot size: .010 + .008 inches Setting depth: From .010 620-680 feet to .008 680-700 feet

Type of completion (circle all applicable): Gravel packed Underreamed Telescoped Open hole Natural Development

Other (describe): _____

Top of lap pipe or reduction in casing: _____ feet. If telescoped or more than one screen, describe on back of page

Logs run (circle all applicable): No log run Electric Gamma Ray Density Sonic Neutron Other: _____

Name of organization running log(s): _____

I certify that the well was drilled, constructed, and completed in accordance with all applicable requirements of the Mississippi Department of Environmental Quality and/or the Mississippi Department of Health regulations and state laws.

John W Thompson 0-679 _____
Print Name of Water Well Contractor and License No. Signature of Water Well Contractor


RECEIVED
FEB 10 2010
BY: OLWR

If well telescopes please sketch below and show depths

Ground Level

Description of Formations Encountered	From	To
clay	0	25
sand + clay	25	40
coarse sand	40	85
blue clay	85	360
sand sea shells + clay	360	520
fine sand + clay	520	620
fine sand	620	680
fine sand + clay	680	740
clay	740	803

More than one screen, show location of each on sketch

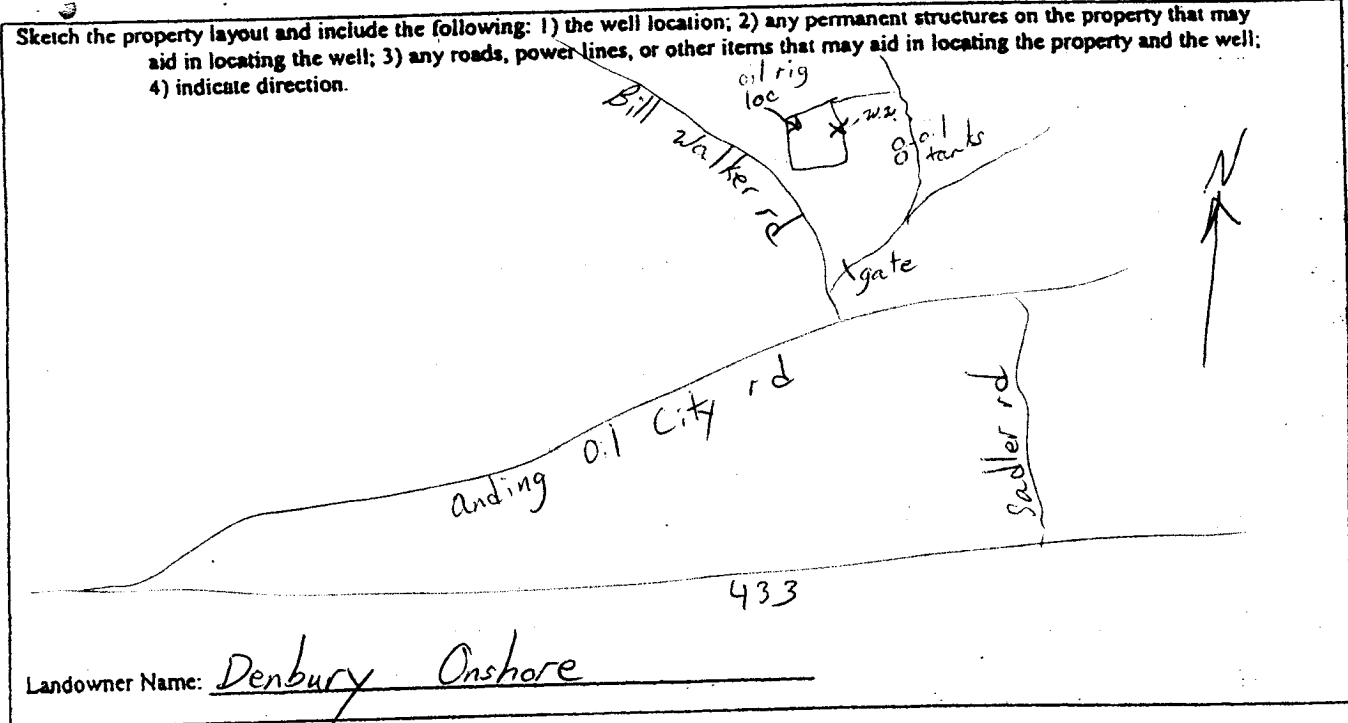

Landowner Name: Denbury Onshore

John W. Hompson
Signature of Water Well Contractor

STATE WELL REPORT

Part 2

Pump Installer's Completion Report
 Mississippi Department of Environmental Quality
 Office of Land and Water Resources
 P.O. Box 10631
 Jackson, MS 39289-0631
 (601)961-5210
 (601)354-6938 (fax)

For Office Use Only:

Aquifer: V 64
 Well #: _____
 Elevation: _____

County: Yazoo
 Permit #: _____
 Driller: John W Thompson
 Date completed: 1-29-10
Copy information from block on Part 1

This part of the report must be completed by a licensed water well contractor or a licensed pump installer. A copy of Part 1 of the report must be attached and both parts filed with the Department at the above address within 30 days of well completion.

Well Owner Information	Well Location
Owner Name: <u>Denbury Onshore</u>	Latitude: _____ Longitude: _____
Mailing Address: <u>P.O. Box 6506</u> <u>Laurel MS</u>	Method of Lat/Long (check one): Conventional Survey _____ USGS quad _____, Hand-held GPS _____, Survey-grade GPS _____
City _____ State _____ Zip Code _____	_____ 1/4 _____ 1/4 Sec <u>1</u> T <u>9N</u> R <u>3W</u>
Telephone No. () _____	Distance _____ Direction _____ Nearest Town _____ <u>5</u> Miles <u>SE</u> of <u>Sartoria</u>

Pump Type Circle one	Power Type Circle one
Air Lift Jet <input checked="" type="radio"/> <u>Submersible</u>	Diesel Engine Gasoline Engine Natural Gas
Bucket Piston Turbine	<input checked="" type="radio"/> <u>Electric Motor</u> Hand Tractor PTO
Centrifugal Rotary Flowing Well	Windmill Other (specify): _____
Other (specify): _____	Horse Power Rating of Motor: <u>7.5</u>
Date Pump Installed: <u>1-29-10</u>	Setting Depth: <u>300</u> feet
Rated Pump Capacity: <u>55</u> Gallons Per Minute	Number of Stages: _____

Pump Test Data	Method of Measuring Water Level Circle one
Date Well Tested: <u>1-29-10</u>	Air Line <input checked="" type="radio"/> <u>Electric Measuring Line</u> Steel Tape
Static Water Level (A): <u>225</u> Feet Below Land Surface	Other (specify): _____
Pumping Water Level (B): <u>245</u> Feet Below Land Surface	For flowing well, measured shut in head: _____ feet
Drawdown [(B) - (A)]: <u>20</u> Feet Below Land Surface	Well yielded <u>50</u> GPM with a drawdown of
Test Pumping Rate: <u>50</u> Gallons Per Minute	<u>20</u> feet after <u>4</u> hours of pumping
Duration of Pump Test (minimum 4 hours): <u>4</u> hours	

I HEREBY CERTIFY that the above statements are true to the best of my knowledge.

John W Thompson 0-679
 Print Name of Pump Installer and License No. (if applicable)

John W Thompson
 Signature of Pump Installer

Form: OLWR-SWR-1B

RECEIVED

FEB 16 2010

BY: OLWR