

Yazoo  
2002  
11/12/76

MISSISSIPPI  
 BOARD OF WATER COMMISSIONERS  
 416 North State Street  
 15K Jackson, Mississippi 39201

WATER WELL DRILLERS LOG

Nov 12, 1976 date well completed      76 E. M. "Bud" CRESSWELL firm name      YAZOO county well located

LANDOWNER:  
Robert L. Johnson  
MADISON, MS.  
 (mailing address)

description of formations encountered	from	to
<u>Clay</u>	<u>0</u>	<u>85</u>
<u>Bank - gravel</u>	<u>85</u>	<u>130</u>

WELL LOCATION:  
 sec. 11 T. 9 N. R. 3 E  
6 miles West of BENTONIA  
 (distance) (direction) (nearest town)

WELL PURPOSE: Irrigation  
 (home, irrigation, municipal, industrial)

- WELL COMPLETION DATA:
- (1) diameter (inches) 4
  - (2) total depth (feet) 130
  - (3) static water level (feet) 80 below top of ground. above
  - (4) casing PVC, 120  
 (material) (depth)  
4 If telescope see back.  
 (size)
  - (5) screen 10, 120  
 (length) (depth to top)  
4, PVC  
 (size) (material)
  - (6) pump 2, 45  
 (HP) (yield gpm)  
0  
 (type power)
  - (7) electric log 0  
 (yes or no)  
0  
 (organization running log)
  - (8) how well bottom plugged None


**RECEIVED**

DEC 1 1976

DRILLERS REMARKS: \_\_\_\_\_

If well telescopes please  
sketch and show depths.

GROUND LEVEL

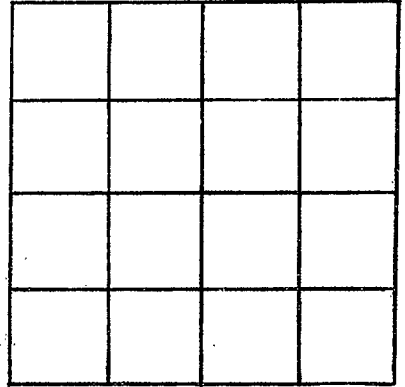

SECTION \_\_\_\_\_

Please indicate well location X.

ADDITIONAL INFORMATION

If more than one screen,  
show locations of each on sketch.