

Yazoo  
 V 2003  
 5-31-77

MISSISSIPPI  
 BOARD OF WATER COMMISSIONERS  
 416 North State Street  
 Jackson, Mississippi 39201

WATER WELL DRILLERS LOG

MAY 31 1977  
 date well completed

15K 77 E. M. "Bud" CRESSWELL  
 firm name

YAZOO  
 county well located


LANDOWNER:	description of formations encountered	from	to
T.G. Sadler			
Benton, Ms. (mailing address)	Clay Sand - gravel	0 60	60 85
<b>WELL LOCATION:</b>			
sec. 12 T. 9 N R. 3 E 5 miles West of Benton (distance) (direction) (nearest town)			
<b>WELL PURPOSE:</b> STOCK (home, irrigation, municipal, industrial)			
<b>WELL COMPLETION DATA:</b>			
(1) diameter (inches) 2			
(2) total depth (feet) 85			
(3) static water level (feet) 70 below top of ground.			
(4) casing PVC 80 (material) (depth)			
2 If telescope see back. (size)			
(5) screen 5 80 (length) (depth to top)			
2 PVC (size) (material)			
(6) pump 1 5 (HP) (yield gpm)			
0 (type power)			
(7) electric log No (yes or no)			
0 (organization running log)			
(8) how well bottom plugged Steel plug			
DRILLERS REMARKS:			

RECEIVED  
 JUN 20 1977

MISS. BD. OF WATER COMMISSIONERS

If well telescopes please sketch and show depths.

GROUND LEVEL

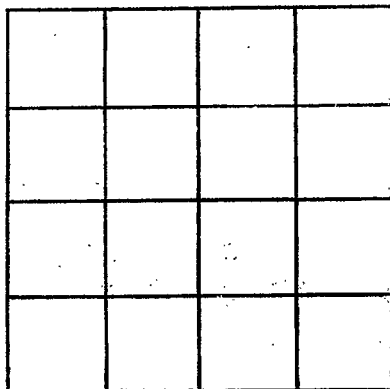

SECTION \_\_\_\_\_

Please indicate well location X.

ADDITIONAL INFORMATION

If more than one screen, show locations of each on sketch.