

YAZOO
 V 2004
 10-14-77

MISSISSIPPI
 BOARD OF WATER COMMISSIONERS
 416 North State Street
 Jackson, Mississippi 39201

WATER WELL DRILLERS LOG

10-14
 date well completed

15K 77 E. Mi. "Bud" Cresswell
 firm name

YAZOO
 county well located

LANDOWNER:	description of formations encountered	from	to
FRANK Keen BENTONIA, MS. (mailing address)			
WELL LOCATION: sec. <u>22</u> T <u>9</u> N R <u>3</u> E 8 miles <u>W</u> of <u>BENTONIA</u> (distance) (direction) (nearest town)			
WELL PURPOSE: <u>None</u> (home, irrigation, municipal, industrial)			
WELL COMPLETION DATA:			
(1) diameter (inches) <u>2</u>			
(2) total depth (feet) <u>95</u>			
(3) static water level (feet) <u>75</u> below top of ground. above			
(4) casing <u>PVC</u> <u>90</u> (material) (depth)			
<u>2</u> (size) if telescope see back.			
(5) screen <u>5</u> <u>90</u> (length) (depth to top)			
<u>2</u> <u>PVC</u> (size) (material)			
(6) pump <u>1</u> <u>5</u> (HP) (yield gpm)			
<u>0</u> (type power)			
(7) electric log <u>no</u> (yes or no)			
<u>None</u> (organization running log)			
(8) how well bottom plugged <u>Steel plug</u>			
DRILLERS REMARKS:			


RECEIVED

OCT 17 1977

MISSISSIPPI WATER COMMISSION

If well telescopes please
sketch and show depths.

GROUND LEVEL

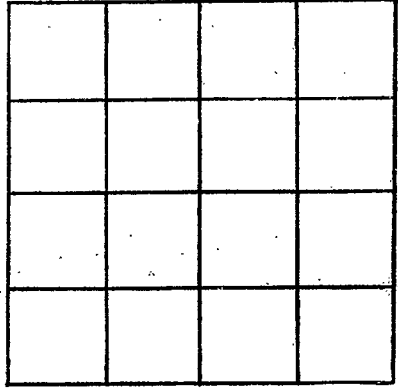

SECTION _____

Please indicate well location X.

ADDITIONAL INFORMATION

If more than one screen,
show locations of each on sketch.