

Yazoo
 2005
 11/21/77

MISSISSIPPI
 BOARD OF WATER COMMISSIONERS
 416 North State Street
 Jackson, Mississippi 39201

WATER WELL DRILLERS LOG

11-21-77 date well completed J.K.M. "Bud" Gresswell firm name Yazoo county well located

LANDOWNER:
 Kenneth Smith
 BENTONIA, MS. 39048
 (mailing address)

description of formations encountered	from	to
Clay	0	40
Sand-gravel	40	90

WELL LOCATION:
 sec. 15 T. 9 N. R. 3 E
 6 miles West of Bentonia
 (distance) (direction) (nearest town)

WELL PURPOSE: home
 (home, irrigation, municipal, industrial)

- WELL COMPLETION DATA:
- (1) diameter (inches) 2
 - (2) total depth (feet) 90
 - (3) static water level (feet) 60 below top of ground.
 - (4) casing PVC 85
 (material) (depth)
2 if telescope see back.
 (size)
 - (5) screen 5 85
 (length) (depth to top)
2 PVC
 (size) (material)
 - (6) pump 1 5
 (HP) (yield gpm)
0
 (type power)
 - (7) electric log 0
 (yes or no)
0
 (organization running log)
 - (8) how well bottom plugged
STEEL PLUG


DRILLERS REMARKS:

RECEIVED
 DEC 15 1977

MISS. Bd. OF WATER COMMISSIONERS

If well telescopes please sketch and show depths.

GROUND LEVEL

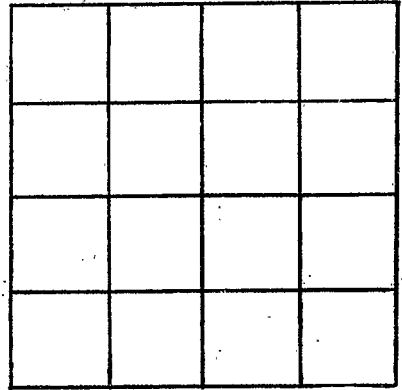

SECTION _____

Please indicate well location X.

ADDITIONAL INFORMATION

If more than one screen, show locations of each on sketch.