

YAZOO  
 V 2006  
 4-21-78

MISSISSIPPI  
 BOARD OF WATER COMMISSIONERS  
 416 North State Street  
 Jackson, Mississippi 39201

WATER WELL DRILLERS LOG

4-21 1978 E.M. "Bud" CRESSWELL Yazoo  
 date well completed firm name county well located

LANDOWNER:  
 T.G. Sadler  
 Benton, Miss. Mississippi  
 (mailing address)

description of formations encountered	from	to
Clay	0	60
Sand gravel	60	90

WELL LOCATION:  
 sec. 12 T 9 N R 3 E  
 5 miles West of Benton, Miss.  
 (distance) (direction) (nearest town)

WELL PURPOSE: Farm  
 (home, irrigation, municipal, industrial)

WELL COMPLETION DATA:

(1) diameter (inches) 2

(2) total depth (feet) 90

(3) static water level (feet) 65 below top of ground

(4) casing (material) Pvc (depth) 85  
 2 (size) if telescope see back.

(5) screen (length) 5 (depth to top) 85  
 2 (size) (material) 85

(6) pump (HP) 1 (yield gpm) 5  
 0 (type power)

(7) electric log No (yes or no)  
 0

(organization running log)

(8) how well bottom plugged  
 Back Wash Valve


DRILLERS REMARKS:

RECEIVED  
 MAY 3 - 1978

MISS. BB. OF WATER COMMISSIONERS

If well telescopes please  
sketch and show depths.

GROUND LEVEL

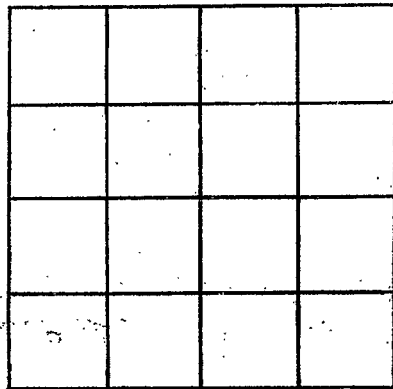

SECTION \_\_\_\_\_

Please indicate well location X.

ADDITIONAL INFORMATION

If more than one screen,  
show locations of each on sketch.