

SE/4 - NW/4 - NW/4

see R...

Yazoo
W16
1-67
Elec Log

MISSISSIPPI
BOARD OF WATER COMMISSIONERS
416 North State Street
Jackson, Mississippi 39201

ELOG #167

WATER WELL DRILLERS LOG

1-11 1967 Bud CRESSWELL Yazoo
date well completed firm name county well located

LANDOWNER:
Bill WALKER
BENTONIA, Miss-
(mailing address)

description of formations encountered	from	to
Yellow clay	0	80
Yazoo clay	80	300
Shale - streaks of sand	300	495
sand - streaks of shale	495	620
shale - sandy	620	660

WELL LOCATION:
sec 9 T 9 N R 2 E
S W
2 miles West of Bentonia
(distance) (direction) (nearest town)

WELL PURPOSE: Domestic
(home, irrigation, municipal, industrial)

WELL COMPLETION DATA:

(1) diameter (inches) 2

(2) total depth (feet) 660

(3) static water level (feet) 130 below above top of ground.

(4) casing Steel 570
(material) (depth)

2 if telescope see back.
(size)

(5) screen 10' 570
(length) (depth to top)

2 Stainless Steel
(size) (material)


(6) pump 1 5
(HP) (yield gpm)

110
(type power)

(7) electric log Yes
(yes or no)

M.S.B.P.
(organization running log)


(8) how well bottom plugged
Drinking

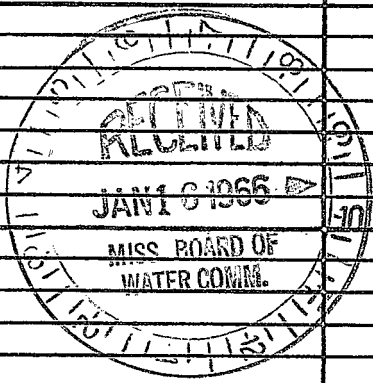

DRILLERS REMARKS:

If well telescopes please sketch and show depths.

GROUND LEVEL

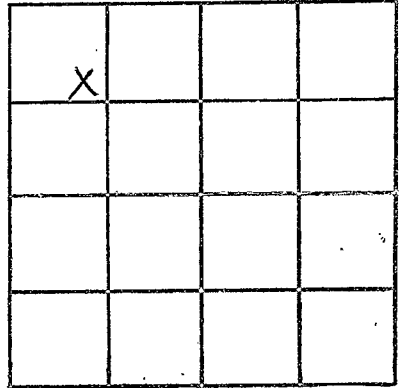

SECTION 9

Please indicate well location X.

ADDITIONAL INFORMATION

If more than one screen, show locations of each on sketch.