

**MISSISSIPPI
BOARD OF WATER COMMISSIONERS**
416 North State Street
Jackson, Mississippi 39201

CODED

CODED

WATER WELL DRILLERS LOG

YAZOO
W17
10-31-68
M.G.S.

10-31 1968 Bud Cresswell Yazoo
date well completed firm name county well located

LANDOWNER:
Cathey-Willford-Jones Co.
Bentonia, Miss.
(mailing address)

| description of formations encountered | from | to |
|---------------------------------------|------|-----|
| Clay yellow | 0 | 50 |
| sand | 50 | 60 |
| blue clay | 60 | 300 |
| sand sea shells | 300 | 320 |
| sandy shale | 320 | 420 |
| shale | 420 | 460 |
| sand coarse | 460 | 505 |
| shale | 505 | 510 |
| sand coarse | 510 | 550 |
| sandy shale | 550 | 640 |


WELL LOCATION:
sec 12 T 9 N R 2 W
Bentonia miles _____ of _____
(distance) (direction) (nearest town)

WELL PURPOSE: industrial
(home, irrigation, municipal, industrial)

WELL COMPLETION DATA:

- (1) diameter (inches) 4 x 3
- (2) total depth (feet) 544
- (3) static water level (feet) 75 below above top of ground.
- (4) casing black pipe,
(material) (depth),
4 if telescope see back.
(size)
- (5) screen b400k p462
(length) (depth to top)
3" stainless
(size) (material)
- (6) pump 5 65
(HP) (yield gpm)
- (type power)
- (7) electric log yes
(yes or no)
Misss Geo. Survey
(organization running log)
- (8) how well bottom plugged _____


CODED

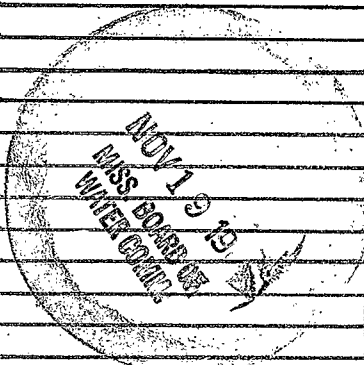

DRILLERS REMARKS:

If well telescopes please sketch and show depths.

GROUND LEVEL

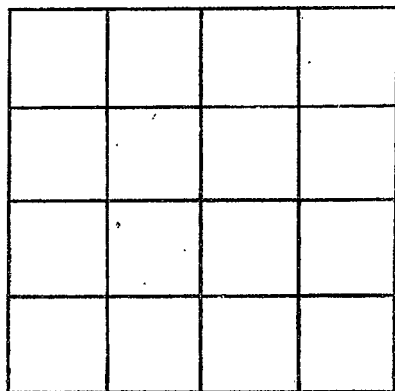

SECTION 12

Please indicate well location X.

ADDITIONAL INFORMATION

If more than one screen,
show locations of each on sketch.