

MISSISSIPPI  
 BOARD OF WATER COMMISSIONERS  
 416 North State Street  
 Jackson, Mississippi 39201

**CODED**

WATER WELL DRILLERS LOG

Yazoo  
 W 21  
 5-13-70

May 13 1970 date well completed  
 Bud Cresswell firm name  
 Yazoo county well located

LANDOWNER:

W.T. Owens

Rt. 2  
 Bentonia, Miss -  
 (mailing address)

description of formations encountered

Clay  
 Sand

from	to
0	12
12	47

WELL LOCATION:

sec 21 T. 9 N R. 2 E  
 4 miles S.W. of Bentonia  
 (distance) (direction) (nearest town)

WELL PURPOSE: Domestic  
 (home, irrigation, municipal, industrial)

WELL COMPLETION DATA:

- (1) diameter (inches) 2
- (2) total depth (feet) 47
- (3) static water level (feet) 18 below top of ground.
- (4) casing galv 42 (material) (depth)  
 20 (size) If telescope see back.
- (5) screen 5 42 (length) (depth to top)  
 2 Stainless (size) (material)
- (6) pump (HP) (yield gpm)  
 No pump installed (type power)
- (7) electric log (yes or no)  
 (organization running log)
- (8) how well bottom plugged

**CODED**


DRILLERS REMARKS:

MAY 21 1970

MISS. Bd. of WATER COMMISSIONERS

If well telescopes please  
sketch and show depths.

GROUND LEVEL

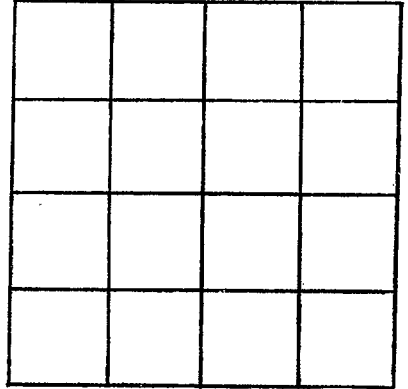

SECTION \_\_\_\_\_

Please indicate well location X.

ADDITIONAL INFORMATION

If more than one screen,  
show locations of each on sketch.