

**MISSISSIPPI
BOARD OF WATER COMMISSIONERS**
416 North State Street
Jackson, Mississippi 39201

CODED

WATER WELL DRILLERS LOG

Yazoo
W22
7-17-70

July 17 1970 E.M. "Bud" Cresswell Yazoo
date/well completed firm name county well located

LANDOWNER:
L.D. Peyton
BENTONIA, Miss-
(mailing address)

description of formations encountered	from	to
	<u>Clay</u> <u>Sandy gravel</u>	<u>0</u>

WELL LOCATION:
sec. 7 T. 10 N. R. 2 E.
5 miles W of Bentonia
(distance) (direction) (nearest town)

WELL PURPOSE: Domestic
(home, irrigation, municipal, industrial)

WELL COMPLETION DATA:

(1) diameter (inches) 2

(2) total depth (feet) 85

(3) static water level (feet) 65 below
top of ground. above

(4) casing galv. 80
(material) (depth)
2 if telescope see back.
(size)

(5) screen 5 80
(length) (depth to top)
2 Stainless
(size) (material)

(6) pump 3/4 5
(HP) (yield gpm)
0
(type power)

(7) electric log No
(yes or no)
0
(organization running log)

(8) how well bottom plugged
Steel plug

CODED


JUL 21 1970

MISS. BD. OF
WATER COMM.

DRILLERS REMARKS:

If well telescopes please sketch and show depths.

GROUND LEVEL

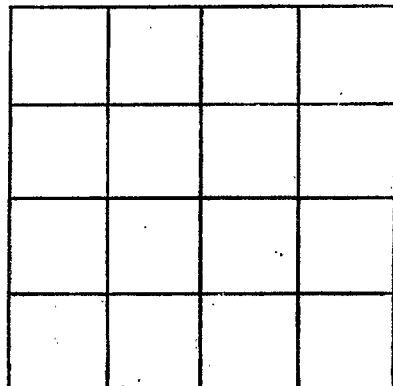

SECTION _____

Please indicate well location X.

ADDITIONAL INFORMATION

If more than one screen,
show locations of each on sketch.