

YAZOO
W 23
10-8-70

MISSISSIPPI
BOARD OF WATER COMMISSIONERS
416 North State Street
Jackson, Mississippi 39201

CODED

WATER WELL DRILLERS LOG

Oct. 8 1970 F.M. "Bud" Cresswell Yazoo
date well completed firm name county well located

LANDOWNER:
Pleasant Grove Church
BENTONIA, Miss-
(mailing address)

description of formations encountered	from	to
<u>Clay</u>	<u>0</u>	<u>60</u>
<u>Sandy gravel</u>	<u>60</u>	<u>89</u>

WELL LOCATION:
sec. 9 T. 9 N R. 2
2 miles East of BENTONIA
(distance) (direction) (nearest town)

WELL PURPOSE: Church
(home, irrigation, municipal, industrial)

- WELL COMPLETION DATA:
- (1) diameter (inches) 2
 - (2) total depth (feet) 89
 - (3) static water level (feet) 30 below above top of ground.
 - (4) casing Steel 84
(material) (depth)
 - 2 if telescope see back.
(size)
 - (5) screen 5 ft 84
(length) (depth to top)
 - 2" stainless
(size) (material)
 - (6) pump 3/4 5
(HP) (yield gpm)
 - 0
(type power)
 - (7) electric log 0
(yes or no)
 - 0
(organization running log)
 - (8) how well bottom plugged steel plug

CODED


OCT 22 1970

DRILLERS REMARKS:

MISSO DD-65
MAY 1968
REVISED 5/68

If well telescopes please sketch and show depths.

GROUND LEVEL

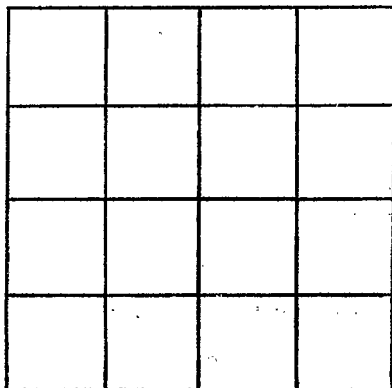

SECTION _____

Please indicate well location X.

ADDITIONAL INFORMATION

If more than one screen,
show locations of each on sketch.