

82
 YAZOO
 W 27
 5-31-72

MISSISSIPPI
 BOARD OF WATER COMMISSIONERS
 416 North State Street
 Jackson, Mississippi 39201

WATER WELL DRILLERS LOG

May 31 - 72 date well completed JETCOAT Drilling Co firm name YAZOO county well located

LANDOWNER: M. Charles Estes
YAZOO City
Miss
 (mailing address)

description of formations encountered	from	to
Clay + Topsoil	0	20
Sand	20	25
Clay	25	43
breaks of fine sand	43	51
Clay break	51	56
sand fair	56	63
		71

WELL LOCATION:
 sec. 4 T. 9 N. R. 2 E.
5 miles NW of Benton
 (distance) (direction) (nearest town)

WELL PURPOSE: dom
 (home, irrigation, municipal, industrial)

- WELL COMPLETION DATA:
- (1) diameter (inches) 2"
 - (2) total depth (feet) 625 ft
 - (3) static water level (feet) 93 below top of ground.
 - (4) casing Gal 1014
 (material) (depth)
 (size) if telescope see back.
 - (5) screen 1014 614
 (length) (depth to top)
2" Stainless steel
 (size) (material)
 - (6) pump 1 3
 (HP) (yield gpm)
AC
 (type power)
 - (7) electric log NO
 (yes or no)
 (organization running log)
 - (8) how well bottom plugged Steel Rod
1/8" + sweep up


DRILLERS REMARKS:
best sand 600 and
630 ft

JUN 9 1972

MISSISSIPPI BOARD OF WATER COMMISSIONERS

If well telescopes please sketch and show depths.

GROUND LEVEL

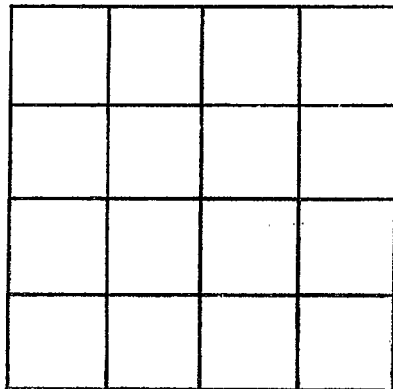

SECTION _____

Please indicate well location X.

ADDITIONAL INFORMATION

If more than one screen, show locations of each on sketch.