

YAZOO
W 29.
1-3-73

MISSISSIPPI
BOARD OF WATER COMMISSIONERS
416 North State Street
Jackson, Mississippi 39201

CODED

WATER WELL DRILLERS LOG

Jan 13 1973 F.M. "Bud" Cresswell Yazoo
date well completed firm name county well located

LANDOWNER:
D.C. Russell
BENTONIA, Miss.
(mailing address)

description of formations encountered	from	to
Clay Sap.	0	30
	30	47

WELL LOCATION:
sec. 21 T. 9 N R. 2 E
3 miles S.W. of BENTONIA
(distance) (direction) (nearest town)

WELL PURPOSE: DOMESTIC
(home, irrigation, municipal, industrial)


- WELL COMPLETION DATA:
- (1) diameter (inches) 2
 - (2) total depth (feet) 47
 - (3) static water level (feet) 20 below top of ground.
 - (4) casing Steel, 42
(material) (depth)
2 if telescope see back.
(size)
 - (5) screen 5, 42
(length) (depth to top)
2, Stainless
(size) (material)
 - (6) pump 3/4, 10
(HP) (yield gpm)
0
(type power)
 - (7) electric log No
(yes or no)
0
(organization running log)
 - (8) how well bottom plugged
steel plug

DRILLERS REMARKS:

DEC 10 1973
JAN 10 1973

If well telescopes please sketch and show depths.

GROUND LEVEL

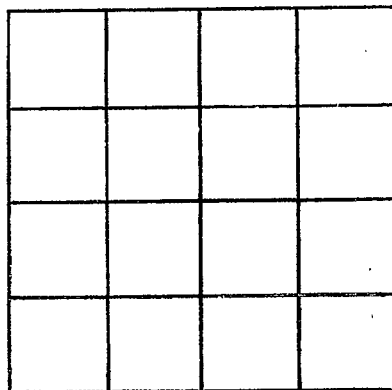

SECTION _____

Please indicate well location X.

ADDITIONAL INFORMATION

If more than one screen,
show locations of each on sketch.