

YAZOO
W30
2-19-73

MISSISSIPPI
 BOARD OF WATER COMMISSIONERS
 416 North State Street
 Jackson, Mississippi 39201

CODED

WATER WELL DRILLERS LOG

Feb-19 1973 K.M. "Bud" Cresswell Yazoo
 date well completed firm name county well located

LANDOWNER:
 J. A. Rucker
 Lintonia, Miss.
 (mailing address)

description of formations encountered	from	to
Clay	0	12
sand	12	47

WELL LOCATION:
 sec. 4 T. 9 N. R. 2 E.
 4 miles SW of Lintonia
 (distance) (direction) (nearest town)

WELL PURPOSE: Home
 (home, irrigation, municipal, industrial)

CODED


- WELL COMPLETION DATA:
- (1) diameter (inches) 2
 - (2) total depth (feet) 47
 - (3) static water level (feet) 18 below above top of ground.
 - (4) casing Steel, 42,
 (material) (depth)
2
 (size) if telescope see back.
 - (5) screen 5, 42
 (length) (depth to top)
2, stainless
 (size) (material)
 - (6) pump 3/4, 10
 (HP) (yield gpm)
0
 (type power)
 - (7) electric log No
 (yes or no)
 (organization running log)
 - (8) how well bottom plugged
Steel plug

DRILLERS REMARKS:

MISSISSIPPI BOARD OF WATER COMMISSIONERS
 JACKSON, MISSISSIPPI 39201

If well telescopes please sketch and show depths.

GROUND LEVEL

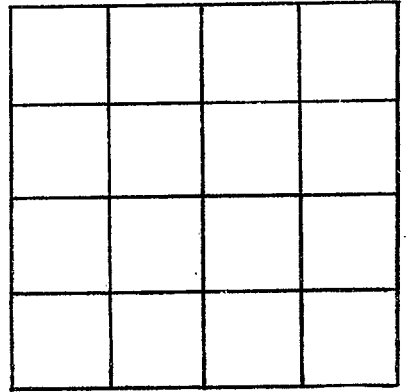

SECTION _____

Please indicate well location X.

ADDITIONAL INFORMATION

If more than one screen,
show locations of each on sketch.