

YAZOO
W31
4-26-73

MISSISSIPPI
BOARD OF WATER COMMISSIONERS
416 North State Street
Jackson, Mississippi 39201

CODED

WATER WELL DRILLERS LOG

April 26 1973 E.M. "Bud" Cresswell Yazoo
 (date well completed) (firm name) (county well located)

LANDOWNER:
Bill Link
Benton, Miss.
(mailing address)

description of formations encountered	from	to
	Clay	0
gravel	10	30
Sand	30	50

WELL LOCATION:
 sec 30 T 7 N R 2 E
 5 miles SW of Benton
 (distance) (direction) (nearest town)

WELL PURPOSE: Farm
 (home, irrigation, municipal, industrial)

WELL COMPLETION DATA:


- (1) diameter (inches) 4
- (2) total depth (feet) 50
- (3) static water level (feet) 12 below top of ground.
- (4) casing Steel 40
 (material) (depth)
 4 (size) If telescope see back.
- (5) screen 10 40
 (length) (depth to top)
 2 stainless
 (size) (material)
- (6) pump 3/4 20
 (HP) (yield gpm)
 0 (type power)
- (7) electric log No
 (yes or no)
 0 (organization running log)
- (8) how well bottom plugged
 Steel plug

DRILLERS REMARKS:

CODED

If well telescopes please sketch and show depths.

GROUND LEVEL

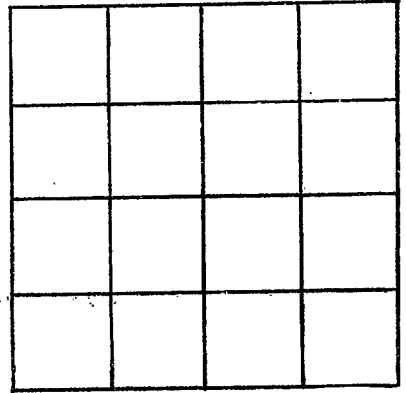

SECTION _____

Please indicate well location X.

ADDITIONAL INFORMATION

If more than one screen,
show locations of each on sketch.