

**CODED**

MISSISSIPPI  
BOARD OF WATER COMMISSIONERS  
416 North State Street  
Jackson, Mississippi 39201

**WATER WELL DRILLERS LOG**

YAZOO  
W 32  
7-30-73

July 30 1973 date well completed  
B. E. M. "Bud" Gesswell firm name  
YAZOO county well located


LANDOWNER:	description of formations encountered	from	to
Betty Mcberry Benton, Miss. (mailing address)			
<b>WELL LOCATION:</b> sec. <u>5</u> T. <u>9</u> N. R. <u>1</u> E. W. <u>3</u> <u>3</u> miles <u>E</u> of <u>Benton</u> (distance) (direction) (nearest town)			
<b>WELL PURPOSE:</b> <u>Home</u> (home, irrigation, municipal, industrial)			
<b>WELL COMPLETION DATA:</b> (1) diameter (inches) <u>2</u> (2) total depth (feet) <u>89</u> (3) static water level (feet) <u>20</u> <small>below</small> <u>above top of ground.            (4) casing <u>Steel</u>, <u>84</u>,                  (material) (depth)                  <u>2</u> if telescope see back.                  (size)            (5) screen <u>5</u>, <u>84</u>                  (length) (depth to top)                  <u>2</u>, <u>Stainless</u>                  (size) (material)            (6) pump <u>3/4</u>, <u>5</u>                  (HP) (yield gpm)                  <u>0</u>                  (type power)            (7) electric log <u>No</u>                  (yes or no)                  <u>0</u>                  (organization running log)            (8) how well bottom plugged                  <u>Steel plugs</u> </u>			
<b>DRILLERS REMARKS:</b>			

**CODED**

AUG 7 1973

If well telescopes please  
sketch and show depths.

GROUND LEVEL

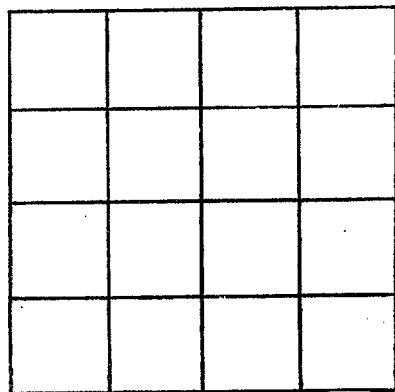

SECTION \_\_\_\_\_

Please indicate well location X.

ADDITIONAL INFORMATION

If more than one screen,  
show locations of each on sketch.