

Y4200  
W 34  
2-19-74

MISSISSIPPI  
BOARD OF WATER COMMISSIONERS  
416 North State Street  
Jackson, Mississippi 39201 CODED  
WATER WELL DRILLERS LOG

Feb. 19 1974 E.M. "BUD" CRESSWELL Y4200  
date well completed firm name county well located

LANDOWNER:  
Velma Burrell  
BENTONIA, Miss. 39040  
(mailing address)

description of formations encountered	from	to
	Clay Sand	0 30

WELL LOCATION:  
sec. 21 T. 9 N R. 2 W  
3 miles South of BENTONIA  
(distance) (direction) (nearest town)

WELL PURPOSE: Home  
(home, irrigation, municipal, industrial)


WELL COMPLETION DATA:  
(1) diameter (inches) 2  
(2) total depth (feet) 47  
(3) static water level (feet) 18 below above top of ground.  
(4) casing Steel 42  
(material) (depth)  
2 if telescope see back.  
(size)  
(5) screen 5 ft. 42  
(length) (depth to top)  
2 " stainless  
(size) (material)  
(6) pump 3/4 10  
(HP) (yield gpm)  
0  
(type power)  
(7) electric log no  
(yes or no)  
0  
(organization running log)  
(8) how well bottom plugged Steel plug

DRILLERS REMARKS:

CODED  
RECORDED  
MAR 13 1974  
MISS. BD. OF WATER COMM

If well telescopes please sketch and show depths.

GROUND LEVEL

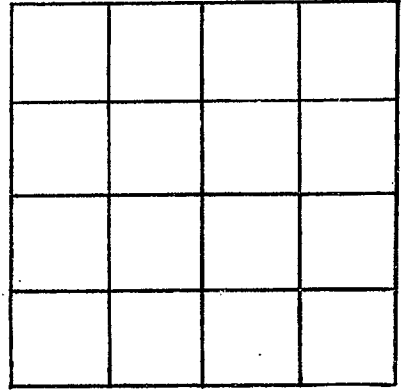

SECTION \_\_\_\_\_

Please indicate well location X.

ADDITIONAL INFORMATION

If more than one screen, show locations of each on sketch.