

YA200
W 35
2-20-74

MISSISSIPPI
BOARD OF WATER COMMISSIONERS
416 North State Street
Jackson, Mississippi 39201

CODED

WATER WELL DRILLERS LOG

Feb. 20 1974
date well completed

74 E.M. "BUD" CRESSWELL
firm name

YA200
county well located

LANDOWNER:
Bully Winbush
Benton, Min. 39046
(mailing address)

description of formations encountered	from	to
<u>Clay</u>	<u>0</u>	<u>30</u>
<u>Sand</u>	<u>30</u>	<u>47</u>


WELL LOCATION:
sec. 21 T. 9 N R. 2 E
3 miles South of Benton
(distance) (direction) (nearest town)

WELL PURPOSE: Home
(home, irrigation, municipal, industrial)

- WELL COMPLETION DATA:
- (1) diameter (inches) 2
 - (2) total depth (feet) 47
 - (3) static water level (feet) 18 below top of ground.
 - (4) casing Steel, 42
(material) (depth)
 - 2 If telescope see back.
(size)
 - (5) screen 5, 42
(length) (depth to top)
 - 2", Stainless
(size) (material)
 - (6) pump none, 10
(HP) (yield gpm)
 - 0
(type power)
 - (7) electric log No
(yes or no)
 - 0
(organization running log)

CODED

(8) how well bottom plugged
Steel plug

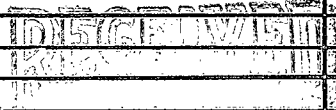


MAR 1 1974

DRILLERS REMARKS:

If well telescopes please
sketch and show depths.

GROUND LEVEL

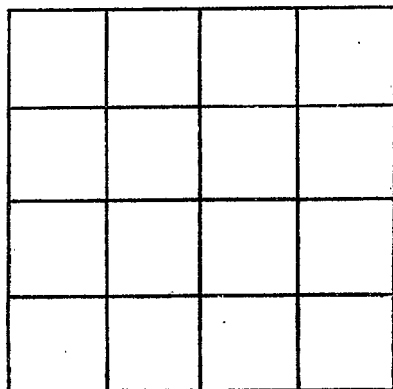

SECTION _____

Please indicate well location X.

ADDITIONAL INFORMATION

If more than one screen,
show locations of each on sketch.