

YAZOO
W 37
1-6-75

MISSISSIPPI
BOARD OF WATER COMMISSIONERS
416 North State Street
Jackson, Mississippi 39201

CODED

WATER WELL DRILLERS LOG

Jan. 6 1975 E.M. "Bud" CRESSWELL Yazoo
date well completed firm name county well located

LANDOWNER:	description of formations encountered	from	to
THOMAS J. KIRK BENTONIA, Miss. 39040 (mailing address)			

WELL LOCATION:
sec. 15 T 9 N R 2 E
2 miles 5 of BENTONIA
(distance) (direction) (nearest town)

WELL PURPOSE: FARM
(home, irrigation, municipal, industrial)


- WELL COMPLETION DATA:
- (1) diameter (inches) 2
 - (2) total depth (feet) 47
 - (3) static water level (feet) 18 below above top of ground.
 - (4) casing Steel 42
(material) (depth)
2 if telescope see back.
(size)
 - (5) screen 5 42
(length) (depth to top)
2 Stainless
(size) (material)
 - (6) pump 3/4 10
(HP) (yield gpm)
0
(type power)
 - (7) electric log No
(yes or no)
0
(organization running log)
 - (8) how well bottom plugged Steel plug

RECEIVED
FEB 6 - 1975

DRILLERS REMARKS:

If well telescopes please
sketch and show depths.

GROUND LEVEL

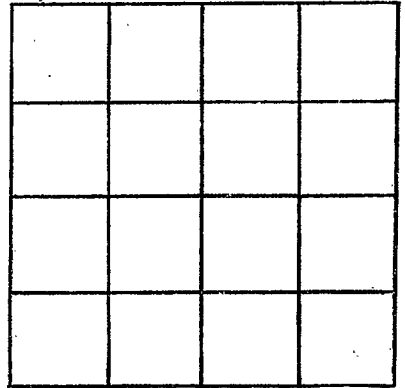

SECTION _____

Please indicate well location X.

ADDITIONAL INFORMATION

If more than one screen,
show locations of each on sketch.