

4A200
 W 38
 10/31/82

MISSISSIPPI
 BOARD OF WATER COMMISSIONERS
 416 North State Street
 Jackson, Mississippi 39201

WATER WELL DRILLERS LOG

Oct. 31 1982 E.M. "Bud" Cresswell Y200
 date well completed firm name county well located

LANDOWNER:	description of formations encountered	from	to
W.S. "Red" Hancock BENTONIA, MS. 39040 (mailing address)			
WELL LOCATION: sec. 11 T 9 N R 2 E AT BENTONIA (distance) (direction) (nearest town)			
WELL PURPOSE: <u>Industrial</u> (home, irrigation, municipal, industrial)			
WELL COMPLETION DATA:			
(1) diameter (inches) <u>6</u>			
(2) total depth (feet) <u>620</u>			
(3) static water level (feet) <u>70</u> below top of ground.			
(4) casing <u>Steel</u> , <u>540</u> , (material) (depth) <u>6</u> if telescope see back. (size)			
(5) screen <u>60</u> <u>540</u> (length) (depth to top) <u>4</u> , <u>Steel</u> (size) (material)			
(6) pump <u>15</u> <u>150</u> (HP) (yield gpm) (type power)			
(7) electric log <u>Yes</u> (yes or no) <u>State</u> (organization running log)			
(8) how well bottom plugged <u>back wash valve</u>			
DRILLERS REMARKS:			

CODER


DEPT. OF NATURAL RESOURCES
 BUREAU OF LAND & WATER RESOURCES

NOV 22 1982

RECEIVED

If well telescopes please sketch and show depths.

GROUND LEVEL

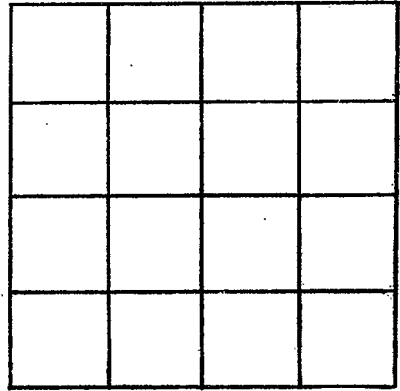

SECTION _____

Please indicate well location X.

ADDITIONAL INFORMATION

A series of horizontal lines for writing additional information, starting below the 'ADDITIONAL INFORMATION' header and extending to the bottom of the page.

If more than one screen, show locations of each on sketch.