

MISSISSIPPI DEPARTMENT OF NATURAL RESOURCES

Bureau of Land and Water Resources

Southport Mall

P.O. Box 10631

Jackson, Mississippi 39209

WATER WELL DRILLERS LOG

Yazoo
W39
CODED

Oct. 1 1987 E.M. Bud Cresswell Yazoo
 date well completed firm name county well located

LANDOWNER:
Memphis Hardwood Co.
BENTONIA, MS.
 (mailing address)

description of formations encountered	from	to
<u>Surface dirt</u>	<u>0</u>	<u>40</u>
<u>Red</u>	<u>40</u>	<u>60</u>
<u>Yazoo Clay</u>	<u>60</u>	<u>300</u>
<u>Mudgy Branch</u>	<u>300</u>	<u>325</u>
<u>Teays shale</u>	<u>325</u>	<u>470</u>
<u>Sand</u>	<u>470</u>	<u>540</u>

WELL LOCATION:
 sec. 11 T. 9 N R. 2 E
W
At Bentonia
 (distance) miles (direction) of (nearest town)

WELL PURPOSE: Industrial
 (home, irrigation, municipal, industrial)

WELL COMPLETION DATA:

(1) diameter (inches) 4

(2) total depth (feet) 540

(3) static water level (feet) 85 below top of ground. ~~above~~

(4) casing PVC 500
 (material) (depth)
4 if telescope see back.
 (size)

(5) screen 40 500
 (length) (depth to top)
4 PVC
 (size) (material)

(6) pump 5 75
 (HP) (yield gpm)
 (type power)

(7) electric log No
 (yes or no)
 (organization running log)

(8) how well bottom plugged Seal
Shank

RECEIVED


OCT 08 1987

Department of Natural Resources
 Bureau of Land & Water Resources

DRILLERS REMARKS:

If well telescopes please sketch and show depths.

GROUND LEVEL

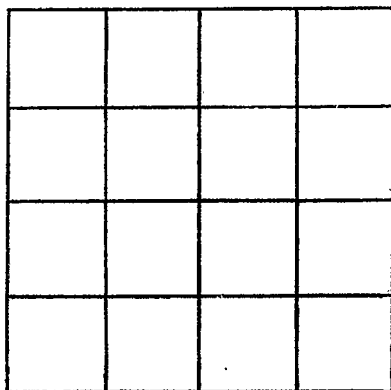

SECTION _____

Please indicate well location X.

ADDITIONAL INFORMATION

If more than one screen,
show locations of each on sketch.