

LAZOO
W 41
1118182

MISSISSIPPI
BOARD OF WATER COMMISSIONERS
416 North State Street
Jackson, Mississippi 39201

WATER WELL DRILLERS LOG

Nov 8, 1982 By E.M. "Bud" Cresswell Yazoo
date well completed firm name county well located

LANDOWNER:
W.S. "Red" Hancock, Inc.
BENTONIA, MS. 39040
(mailing address)

WELL LOCATION:
sec. 1 T. 9 N R. 2 W
1 miles EAST of BENTONIA
(distance) (direction) (nearest town)

WELL PURPOSE: Industrial
(home, irrigation, municipal, industrial)

WELL COMPLETION DATA:
(1) diameter (inches) 6
(2) total depth (feet) 1400
(3) static water level (feet) 110 below top of ground.
(4) casing Steel 1340
(material) (depth)
6 if telescope see back.
(size)
(5) screen 60 1340
(length) (depth to top)
3 Stainless
(size) (material)
(6) pump 10 100
(HP) (yield gpm)
(type power)
(7) electric log Yes
(yes or no)
State
(organization running log)

(8) how well bottom plugged
bad wash & shun

DRILLERS REMARKS:

description of formations encountered	from	to
Clay	0	40
sand	40	80
Clay	80	385
Shale	385	440
fine sand	440	510
Shale	510	650
sand	650	680
shale - rock	680	1300
sand - gravel	1300	1400

CODED


DEPT. OF NATURAL RESOURCES
BUREAU OF LAND & WATER RESOURCES

NOV 22 1982

RECEIVED

If well telescopes please sketch and show depths.

GROUND LEVEL

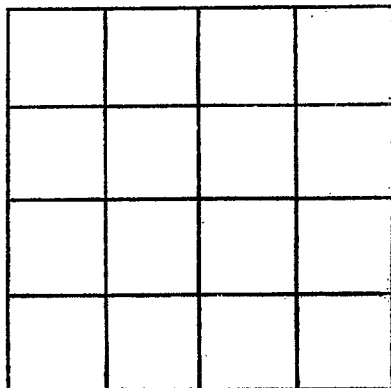

SECTION _____

Please indicate well location X.

ADDITIONAL INFORMATION

If more than one screen,
show locations of each on sketch.