

YA200

WATER WELL DRILLERS LOG

W2001

Date: June 3, 1965, Driller: Creech & Cresswell County Yazoo

(Name)

(1) Owner of Land: Woodbine Place  
(Name)  
Benton, Miss.  
(Address)

(2) Location: 1/4, 1/4, Sec. 10 T9R20  
1 miles West, of Benton  
(distance) (direction) (Nearest Town)

(3) Topography: Flat  
(Hilly) (Flat) (Level)

(4) Purpose of Well: Domestic  
(Domestic Irrigation  
Municipal, Industrial, Other)

Description & Color of Materials Sand, Clay, Red Clay, Shell, etc.	Thick- ness Feet	Depth Feet
Clay	40	40
Sand	20	60
Blue Clay	280	340
Shale + Hard Sand	140	480
<del>Shale</del> Dry Sand	160	640


Information upon completion of well:

- (1) Diameter 4x2 inches.
- (2) Total Depth 640 feet.
- (3) Water Level 120 (R) feet below top of ground.
- (4) Cased to 300, Size 4"
- (5) Screen: Size \_\_\_\_\_, Length \_\_\_\_\_.
- (6) Were any formations sealed against pollution?  
\_\_\_\_\_ yes, \_\_\_\_\_ no.

If YES depth of formation \_\_\_\_\_

Why \_\_\_\_\_

Drillers Remarks: \_\_\_\_\_

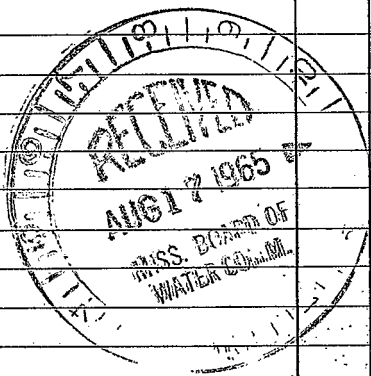

(Use Back Side)

Well No.

