

2400
 W 2000
 10-16-75

MISSISSIPPI
 BOARD OF WATER COMMISSIONERS
 416 North State Street
 Jackson, Mississippi 39201

WATER WELL DRILLERS LOG

10-16 date well completed 1975 E. Mi. "Bud" Cresswell firm name YA 200 county well located


LANDOWNER:	description of formations encountered	from	to
David Spencer Bentonia, Ms. 39040 (mailing address)	Clay Sand-graup	0 25	25 68
WELL LOCATION: sec. 8 T 9 N R 2 E 15K 4 miles West of Bentonia (distance) (direction) (nearest town)			
WELL PURPOSE: home (home, irrigation, municipal, industrial)			
WELL COMPLETION DATA:			
(1) diameter (inches) 2			
(2) total depth (feet) 68			
(3) static water level (feet) 50 below top of ground.			
(4) casing Steel, 63 (material) (depth)			
2 (size) if telescope see back.			
(5) screen 5, 63 (length) (depth to top)			
2, Stainless (size) (material)			
(6) pump 1, 10 (HP) (yield gpm)			
0 (type power)			
(7) electric log No (yes or no)			
0 (organization running log)			
(8) how well bottom plugged Seal plug			
DRILLERS REMARKS:			

NOV 11 1975

MISS. Bd. OF WATER COMMISSIONERS

If well telescopes please sketch and show depths.

GROUND LEVEL

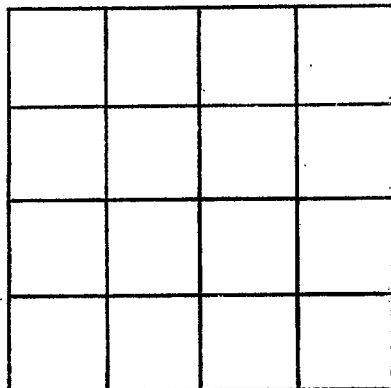

SECTION _____

Please indicate well location X.

ADDITIONAL INFORMATION

If more than one screen, show locations of each on sketch.