

Yazoo
 W 2003
 10-24-75

MISSISSIPPI
 BOARD OF WATER COMMISSIONERS
 416 North State Street
 Jackson, Mississippi 39201

WATER WELL DRILLERS LOG

10-24
 date well completed

1975 E.M. "Bud" CRESSWELL
 firm name

YAZOO
 county well located

LANDOWNER:
 New Pleasant Grove M.B. Church
 Benton, Ms. 39006
 (mailing address)

description of formations encountered	from	to
Red clay	0	30
Blue clay	30	320
Sand	320	350
Sandy shale	350	380
Sand	380	440

WELL LOCATION:
 sec. 3 T 9 N R 2 E 15K
 1 miles NW of BENTONIA
 (distance) (direction) (nearest town)

WELL PURPOSE: CHURCH
 (home, irrigation, municipal, industrial)

- WELL COMPLETION DATA:
- (1) diameter (inches) 2
 - (2) total depth (feet) 440
 - (3) static water level (feet) 85 below above top of ground.
 - (4) casing Steel, 420
 (material) (depth)
2 if telescope see back.
 (size)
 - (5) screen 20, 420
 (length) (depth to top)
2, Stainless
 (size) (material)
 - (6) pump air compressor
 (HP) (yield gpm)
0
 (type power)
 - (7) electric log No
 (yes or no)
0
 (organization running log)
 - (8) how well bottom plugged
Steel plug


RECEIVED
 NOV 12 1975

DRILLERS REMARKS:

MISS. BD. OF WATER COMMISSIONERS

If well telescopes please sketch and show depths.

GROUND LEVEL

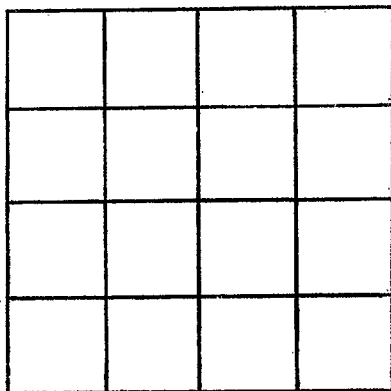

SECTION _____

Please indicate well location X.

ADDITIONAL INFORMATION

A series of horizontal lines providing space for additional information.

If more than one screen, show locations of each on sketch.