

YAZOO  
 W  
 2-11-76

MISSISSIPPI  
 BOARD OF WATER COMMISSIONERS  
 416 North State Street  
 Jackson, Mississippi 39201

WATER WELL DRILLERS LOG

2/11/76  
 date well completed

E.M. "Bud" Crenshaw  
 firm name


Yazoo  
 county well located

LANDOWNER:	description of formations encountered	from	to
Frank Jindall Benton, Mo. (mailing address)			
<b>WELL LOCATION:</b>			
sec. 6 T. 9 N. R. 1 E. W. 1			
2 miles East of Benton (distance) (direction) (nearest town)			
<b>WELL PURPOSE:</b> Home (home, irrigation, municipal, industrial)			
<b>WELL COMPLETION DATA:</b>			
(1) diameter (inches) 2			
(2) total depth (feet) 68			
(3) static water level (feet) 3.5 below top of ground.			
(4) casing Steel 63 (material) (depth)			
2 If telescope see back. (size)			
(5) screen 5 63 (length) (depth to top)			
2 stainless (size) (material)			
(6) pump 1 10 (HP) (yield gpm)			
0 (type power)			
(7) electric log No (yes or no)			
0 (organization running log)			
(8) how well bottom plugged Steel plug			
<b>DRILLERS REMARKS:</b>			

RECEIVED  
 FEB 24 1976

If well telescopes please sketch and show depths.

GROUND LEVEL

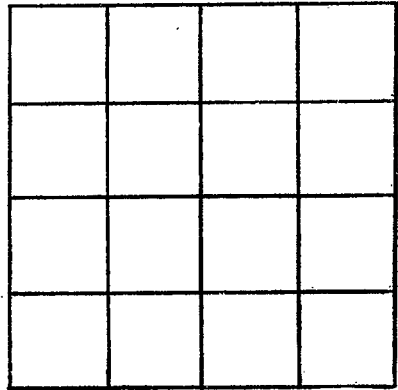

SECTION \_\_\_\_\_

Please indicate well location X.

ADDITIONAL INFORMATION

If more than one screen, show locations of each on sketch.