

**MISSISSIPPI
BOARD OF WATER COMMISSIONERS**
416 North State Street
Jackson, Mississippi 39201

15K

WATER WELL DRILLERS LOG

Yazoo
W 2002
11/4/76

No. 4
date well completed

19 *76 E. M. "Bud" Cresswell*
firm name

Yazoo
county well located


LANDOWNER:	description of formations encountered	from	to
<i>FRANKIE BURTON</i>			
<i>BENTONIA, MS.</i> (mailing address)	<i>CLAY SAND</i>	<i>0</i>	<i>30</i> <i>30</i> <i>66</i>
WELL LOCATION: sec. <u>1</u> T <u>9</u> N R. <u>2</u> <u>1</u> miles <u>EAST</u> of <u>BENTONIA</u> (distance) (direction) (nearest town)			
WELL PURPOSE: <u>home</u> (home, irrigation, municipal, industrial)			
WELL COMPLETION DATA: (1) diameter (inches) <u>2</u> (2) total depth (feet) <u>66</u> (3) static water level (feet) <u>20</u> below above top of ground. (4) casing <u>PVC</u> <u>61</u> (material) (depth) <u>2</u> if telescope see back. (size) (5) screen <u>5</u> <u>61</u> (length) (depth to top) <u>2</u> <u>PVC</u> (size) (material) (6) pump <u>1</u> <u>12</u> (HP) (yield gpm) <u>0</u> (type power) (7) electric log <u>0</u> (yes or no) <u>0</u> (organization running log)			
(8) how well bottom plugged <u>Steel Plug</u>			
DRILLERS REMARKS:			

RECEIVED

DEC 1 1976

If well telescopes please sketch and show depths.

GROUND LEVEL

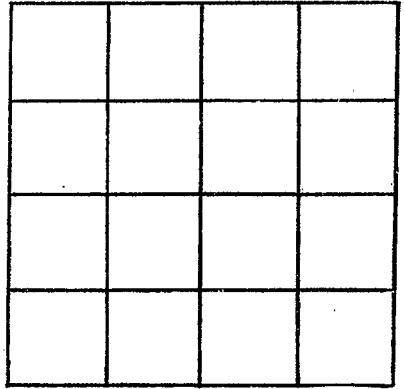

SECTION _____

Please indicate well location X.

ADDITIONAL INFORMATION

If more than one screen,
show locations of each on sketch.