

4200  
 W 2009  
 4-5-77

MISSISSIPPI  
 BOARD OF WATER COMMISSIONERS  
 416 North State Street  
 15K Jackson, Mississippi 39201

WATER WELL DRILLERS LOG

April 5 1977 E.M. "Bud" Cresswell Yazoo  
 date well completed firm name county well located

LANDOWNER:	description of formations encountered	from	to
Able Slater			
Bentonia Mo. (mailing address)	Sand	45	60

WELL LOCATION:  
 sec. 9 T. 9 N R. 2 E  
 4 miles West of Bentonia  
 (distance) (direction) (nearest town)

WELL PURPOSE: Home  
 (home, irrigation, municipal, industrial)

- WELL COMPLETION DATA:
- (1) diameter (inches) 2
  - (2) total depth (feet) 60
  - (3) static water level (feet) 50 below top of ground above
  - (4) casing PVC 55  
 (material) (depth)  
 2 (size) if telescope see back.
  - (5) screen 5 55  
 (length) (depth to top)  
 2 PVC  
 (size) (material)
  - (6) pump 3/4 5  
 (HP) (yield gpm)  
 0 (type power)
  - (7) electric log No  
 (yes or no)  
 0 (organization running log)


(8) how well bottom plugged  
 Shell plug  
 DRILLERS REMARKS: 0

RECEIVED

APR 12 1977

If well telescopes please  
sketch and show depths.

GROUND LEVEL

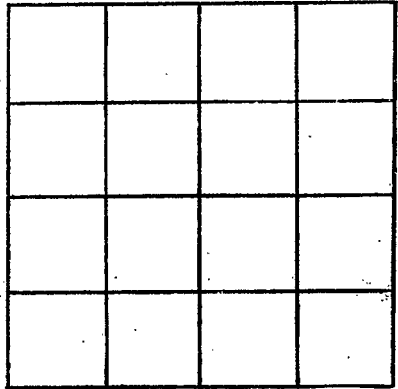

SECTION \_\_\_\_\_

Please indicate well location X.

ADDITIONAL INFORMATION

If more than one screen,  
show locations of each on sketch.