

Yazoo
 W 2000
 8/8/77

MISSISSIPPI
 BOARD OF WATER COMMISSIONERS
 416 North State Street
 15K Jackson, Mississippi 39201

WATER WELL DRILLERS LOG

Aug. 8 1977 F.M. "Bud" Cresswell Yazoo
 date/well completed firm name county well located

LANDOWNER:	description of formations encountered	from	to
Rudy Irwin Benton, MS. (mailing address)			

WELL LOCATION:
 sec. 22 T 9 N R. 2 E
 1 1/2 miles South of Benton, MS.
 (distance) (direction) (nearest town)

WELL PURPOSE: Home
 (home, irrigation, municipal, industrial)

- WELL COMPLETION DATA:
- (1) diameter (inches) 2
 - (2) total depth (feet) 55
 - (3) static water level (feet) 20 below above top of ground.
 - (4) casing PVC 50
 (material) (depth)
 - 2 If telescope see back.
 (size)
 - (5) screen 5 50
 (length) (depth to top)
 - 2 PVC
 (size) (material)
 - (6) pump 1 10
 (HP) (yield gpm)
 - 0
 (type power)
 - (7) electric log No
 (yes or no)
 - 0
 (organization running log)


(8) how well bottom plugged
 Steel plug

DRILLERS REMARKS:

RECEIVED
 AUG 12 1977

If well telescopes please sketch and show depths.

GROUND LEVEL

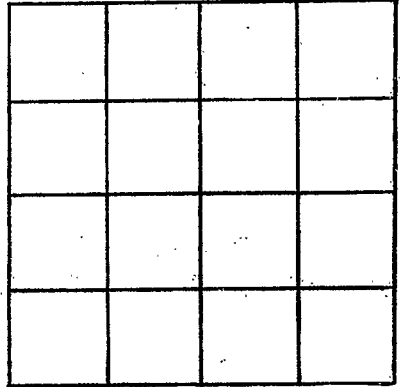

SECTION _____

Please indicate well location X.

ADDITIONAL INFORMATION

If more than one screen, show locations of each on sketch.