

YAZOO
W 2011

**MISSISSIPPI  
BOARD OF WATER COMMISSIONERS**  
416 North State Street  
Jackson, Mississippi 39201

**WATER WELL DRILLERS LOG**


6-29 1978 E.M. "Bud" Gresswell Yazoo  
 date well completed                      firm name                      county well located

LANDOWNER:	description of formations encountered	from	to
W.M. Link Jr. BENTONIA, MS. 39040 (mailing address)			
<b>WELL LOCATION:</b> sec 29 T 9 N R 2 W 3 miles SW of BENTONIA (distance) (direction) (nearest town)			
<b>WELL PURPOSE:</b> FARM (home, irrigation, municipal, industrial)			
<b>WELL COMPLETION DATA:</b>			
(1) diameter (inches) 2			
(2) total depth (feet) 45			
(3) static water level (feet) 18 below top of ground			
(4) casing PVC 40 (material) (depth)			
2 (size) if telescope see back.			
(5) screen 5 40 (length) (depth to top)			
2 PVC (size) (material)			
(6) pump 1 10 (HP) (yield gpm)			
0 (type power)			
(7) electric log No (yes or no)			
(organization running log)			
(8) how well bottom plugged Steel Plug			
<b>DRILLERS REMARKS:</b>			

**RECEIVED**  
JUL 19 1978  
WATER COMMISSIONERS

If well telescopes please sketch and show depths.

GROUND LEVEL

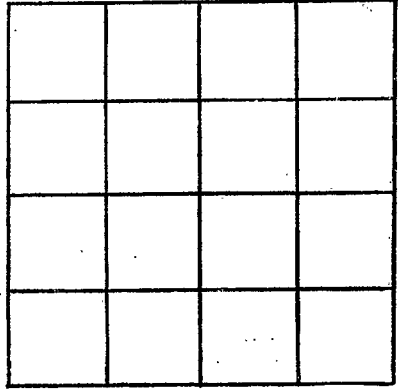

SECTION \_\_\_\_\_

Please indicate well location X.

ADDITIONAL INFORMATION

If more than one screen, show locations of each on sketch.