

YAZOO

W 202

8/07/79

MISSISSIPPI BOARD OF WATER COMMISSIONERS  
416 North State Street  
Jackson, Mississippi 39201

WATER WELL DRILLERS LOG

August 7 1979  
date well completed

79 E.M. "Bud" Casswell  
firm name

Yazoo  
county well located

LANDOWNER:	description of formations encountered	from	to
Jimmy Alexander			
BENTONIA, Mo. 39040 (mailing address)	Blue clay	50	460
WELL LOCATION:	Sandy shale	460	510
sec 20 T 9 N R 2 W	Sand	510	640
3 miles South of BENTONIA (distance) (direction) (nearest town)			
WELL PURPOSE: Home (home, irrigation, municipal, industrial)			
WELL COMPLETION DATA:			
(1) diameter (inches) 4			
(2) total depth (feet) 640			
(3) static water level (feet) 75 below above top of ground.			
(4) casing PVC 600 (material) (depth)			
4 (size) if telescope see back.			
(5) screen 40 600 (length) (depth to top)			
2 PVC (size) (material)			
(6) pump 1 20 (HP) (yield gpm)			
0 (type power)			
(7) electric log No (yes or no)			
(organization running log)			
(8) how well bottom plugged Steel plug			
DRILLERS REMARKS:			


Miss. Board of Water Comm.

AUG 15 1979

RECEIVED

If well telescopes please sketch and show depths.

GROUND LEVEL

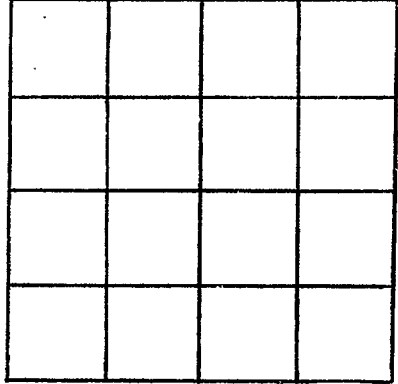

SECTION \_\_\_\_\_

Please indicate well location X.

ADDITIONAL INFORMATION

A series of horizontal lines for recording additional information, starting below the 'ADDITIONAL INFORMATION' header and extending to the bottom of the page.

If more than one screen, show locations of each on sketch.