

MISSISSIPPI DEPARTMENT OF NATURAL RESOURCES

Bureau of Land and Water Resources

Southport Mall

P.O. Box 10631

Jackson, Mississippi 39209

WATER WELL DRILLERS LOG

Yazoo
W 2053

Nov. 10 1983 E.M. "Bud" Cresswell Yazoo
date well completed firm name county well located

LANDOWNER:	description of formations encountered	from	to
JACK Landrum			
BENTONIA, MS. (mailing address)	Shale -	12	52

WELL LOCATION:
sec 15 T 109 N R 1 E
10 miles West of BentonIA
(distance) (direction) (nearest town)

WELL PURPOSE: Farm
(home, irrigation, municipal, industrial)

WELL COMPLETION DATA:

(1) diameter (inches) 3

(2) total depth (feet) 52

(3) static water level (feet) 15 below top of ground.

(4) casing PVC 47 (material) (depth)
3 (size) if telescope see back.

(5) screen 5 47 (length) (depth to top)
2 Stainless (size) (material)

(6) pump 1 20 (HP) (yield gpm)
(type power)

(7) electric log no (yes or no)
(organization running log)

(8) how well bottom plugged
Back Wash Valve

DRILLERS REMARKS:


DEPT. OF NATURAL RESOURCES
BUREAU OF LAND & WATER RESOURCES

NOV 23 1983

RECEIVED

If well telescopes please sketch and show depths.

GROUND LEVEL

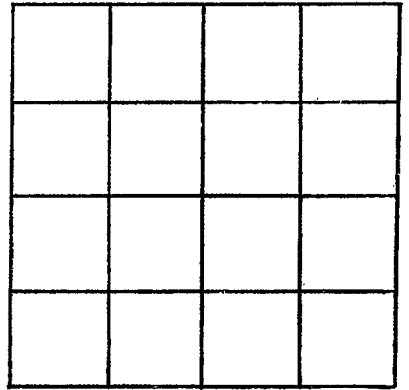

SECTION _____

Please indicate well location X.

ADDITIONAL INFORMATION

If more than one screen,
show locations of each on sketch.