

MISSISSIPPI DEPARTMENT OF NATURAL RESOURCES

Bureau of Land and Water Resources

Southport Mall

P.O. Box 10631

Jackson, Mississippi 39209

WATER WELL DRILLERS LOG

W 2014  
 YAZOO  
 4-2-85

April 2 1985 E.M. Bud Cresswell Yazoo  
 date well completed firm name county well located


LANDOWNER:	description of formations encountered	from	to
FRANK TINDALL	Surface	0	20
BENTONIA, MS 39046 (mailing address)	sand	20	70
<b>WELL LOCATION:</b>			
sec. <u>6</u> T. <u>9</u> N R. <u>1</u> E			
<u>3</u> miles <u>EAST</u> of <u>Benton</u> (distance) (direction) (nearest town)			
<b>WELL PURPOSE:</b> <u>Home</u>			
(home, irrigation, municipal, industrial)			
<b>WELL COMPLETION DATA:</b>			
(1) diameter (inches) <u>2</u>			
(2) total depth (feet) <u>70</u>			
(3) static water level (feet) <u>30</u> below above top of ground.			
(4) casing <u>PVC</u> <u>60</u> (material) (depth)			
<u>2</u> if telescope see back. (size)			
(5) screen <u>10</u> <u>60</u> (length) (depth to top)			
<u>2</u> <u>PVC</u> (size) (material)			
(6) pump <u>1</u> <u>12</u> (HP) (yield gpm)			
(type power) <u>No</u>			
(7) electric log (yes or no)			
(organization running log)			
(8) how well bottom plugged <u>back wash valve</u>			
<b>DRILLERS REMARKS:</b>			

RECEIVED  
 APR 8 - 1985

Department of Natural Resources  
 Bureau of Land & Water Resources

If well telescopes please sketch and show depths.

GROUND LEVEL

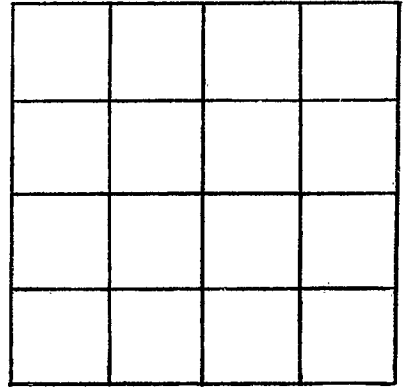

SECTION \_\_\_\_\_

Please indicate well location X.

ADDITIONAL INFORMATION

If more than one screen,  
show locations of each on sketch.