

MISSISSIPPI DEPARTMENT OF ENVIRONMENTAL QUALITY
Bureau of Land and Water Resources

P. O. Box 10631
Jackson, MS 39289-0631
WATER WELL DRILLERS LOG

COUNTY WELL LOCATED YAZOO	
WELL NUMBER W	CODED
DATE WELL COMPLETED Sept. 4, 1991	

PERMIT NUMBER
NAME OF DRILLING FIRM E.M. Bud RESSWELL
BENTONIA, MS. 39040

NAME & MAILING ADDRESS OF LANDOWNER J. W. STEVENS		
YAZOO CITY, MS.		
WELL LOCATION: SEC	TOWNSHIP	RANGE
32	9	1
	N	W
DISTANCE	DIRECTION	NEAREST TOWN
3	South	Eden
OTHER LANDMARK		
WELL PURPOSE: Home Irrigation, Municipal, Industrial, Fish Pond, etc.		

PUMP DATA		
PUMP TYPE (Circle One): <u>Submersible</u> Turbine, Jet, Flowing Well, Other (Describe)		
POWER TYPE (Circle One): <u>Electric</u> Tractor, Diesel, Gasoline, Butane, Other (Describe) H/P 1/2		
Pump Capacity (GPM) 5	No. of Stages 10	Setting Depth 63 FT.
PUMP TEST		
Well yielded 10 GPM with a drawdown of 20 ft. after 1 hours of pumping		

WELL DATA		
Well Depth 95	Casing Diameter (In.) 4	Casing Length (Ft.) 85
Type of Casing PVC	Hole Depth 95	Depth to Static Water Level 30
TYPE OF COMPLETION: (Circle One or More): <u>Gravel Packed</u> , Underreamed, Telescoped, <u>Natural Development</u> , Open Hole, Other (Describe)		
Top of Lap Pipe or Reduction in Casing		
FEET	IF TELESCOPED OR MORE THAN ONE SCREEN: USE BACK PAGE	

LOG DATA	
TYPE OF LOG RUN (Circle One): Electric, Gamma Ray, Density, Sonic, <u>No Log Run</u> , Other (Describe)	
Name of Organization Running Log	

SCREEN DATA		
Diameter - Inches 4	Length - Feet 10	Slot Size - Inches .015
Screen Type PVC	Depth to Bottom - Feet 95	


GEOLOGIC DATA (Office Use Only)			
Surface Elev.	Geologic Unit	Unit Thickness	Depth to Top
Subs. SWL	Date	Analysis	Aquifer Test
Driller's Remarks			

DESCRIPTION OF FORMATIONS ENCOUNTERED	FROM	TO
Clay	0	80
Sand	80	95

FORMATIONS (Continued)	FROM	TO
RECEIVED		
SEP 17 1991		
Dept. of Environmental Quality Bureau of Land & Water Resources		
IF MORE SPACE IS NEEDED, USE BACK		

If well telescopes please
sketch and show depths.

GROUND LEVEL

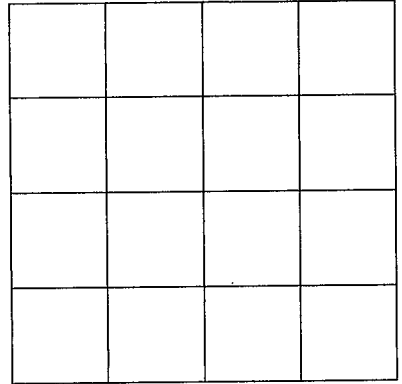

SECTION _____

Please indicate well location X.

ADDITIONAL INFORMATION

If more than one screen,
show location of each on sketch.