

0230032-01
might be Flo.

Well No. _____

F5

FORM 9-1642
(11-68)

03170009

WELL SCHEDULE

U. S. DEPT. OF THE INTERIOR

GEOLOGICAL SURVEY

WATER RESOURCES DIVISION

MAR 27 1965

MASTER CARD

Record by PEG ^{WTR} Source of data driller Date 3/65 Map Kiln Quad

State 28 County HANCOCK ⁵⁴ 23

Latitude: 30² 23⁰ 8⁸ N Longitude: 08⁹ 27⁴ 3³ Sequential number: 1

Lat-long accuracy: 30 T. 7 R. 15 Sec 35 SE NE, SW, SE

Local well number: F005 D3507 S15W Other number: M² Lead Water Park

Local use: 024 465 20 Owner or name: Formally - Wm. Bosworth

Owner or name: NASA MTF Address: Kiln

Ownership: County, Fed Gov't, City, Corp or Co, Private, State Agency, Water Dist F

Use of water: (A) Air cond, (B) Bottling, (C) Comm, (D) Dewater, (E) Power, (F) Fire, (G) Dom, (H) Irr, (I) Med, (J) Ind, (K) P S, (L) Rec, (M) Stock, (N) Instit, (O) Unused, (P) Repressure, (Q) Recharge, (R) Desal-P S, (S) Desal-other, (T) Other Swim pool

Use of well: (A) Anode, (B) Drain, (C) Seismic, (D) Heat Res, (E) Obs, (F) Oil-gas, (G) Recharge, (H) Test, (I) Unused, (J) Withdraw, (K) Waste, (L) Destroyed. W

DATA AVAILABLE: Well data Freq. W/L meas: Field aquifer char.

Hyd. lab. data: MOCN

Qual. water data; type: _____

Freq. sampling: _____ Pumpage inventory: yes no, period: _____

Aperture cards: _____ yes

Log data: D

WELL-DESCRIPTION CARD

SAME AS ON MASTER CARD Depth well: 644 ft Meas. 3

Depth cased: 584 ft Casing type: _____; Diam. 6 in

Finish: (C) concrete, (F) porous gravel w. (perf.), (G) gravel w. (screen), (H) horiz. open gallery, (I) end, (J) other, (K) perf., (L) screen, (M) sd. pt., (N) shored, (O) open hole, (P) other

Method: (A) air bored, (B) cable, (C) dug, (D) hyd jetted, (E) rot., (F) air percussion, (G) rot., (H) reverse, (I) trenching, (J) driven, (K) wash, (L) other

Date Drilled: 950 Pump intake setting: _____ ft

Driller: SUTTER

Lift (type): (A) air, (B) bucket, (C) cent, (D) jet, (E) multiple, (F) multiple, (G) none, (H) piston, (I) rot, (J) submerg, (K) turb, (L) other Deep Shallow

Power (type): (A) diesel, (B) elec, (C) gas, (D) gasoline, (E) hand, (F) gas, (G) wind; H.P. Trans. or meter no. _____

Descrip. MP 8 ft above LSD, Alt. MP _____

Alt. LSD: 15 Accuracy: (source) topo

Water Level: +30 Accuracy: _____

Date meas: 465 Yield: flows 750 gpm 300 Method determined

Drawdown: _____ ft Accuracy: _____ Pumping period: _____ hrs

QUALITY OF WATER DATA: Iron _____ Sulfate _____ Chloride _____ Hard. _____

Sp. Conduct 380 K x 10⁶ Temp. 22.5 °F Date sampled _____

Taste, color, etc. _____

Well No. _____

DEPARTMENT OF ENVIRONMENTAL QUALITY - OLWR

PUBLIC SUPPLY WELLS PROJECT

GPS LOG

USER NAME(S): STEWART/EVERETT DATE: 8/21/96

UNIT DEQ #: _____ FILE #: A082121A

HEALTH DEPT. #: 230032-01 ELEV. 8'

USGS #: F5 OLWR #: _____

OWNER: M.F. LEOD STATE PARK QUAD: KILN

LOCATION: SE/SW/SE S 35 T 75 R 15W COUNTY: HANCOCK


LOCATION DESCRIPTION: _____

CASING DIA: _____ PUMP TYPE & SIZE: _____

GPS FIELD LOCATION: LAT. 30°23.239' LONG. 89°27.905'

GPS CORRECTED LOCATION: LAT. 30.386854 LONG. 89.464990
~~30.30992484~~ ~~89.36833976~~

REMARKS: _____

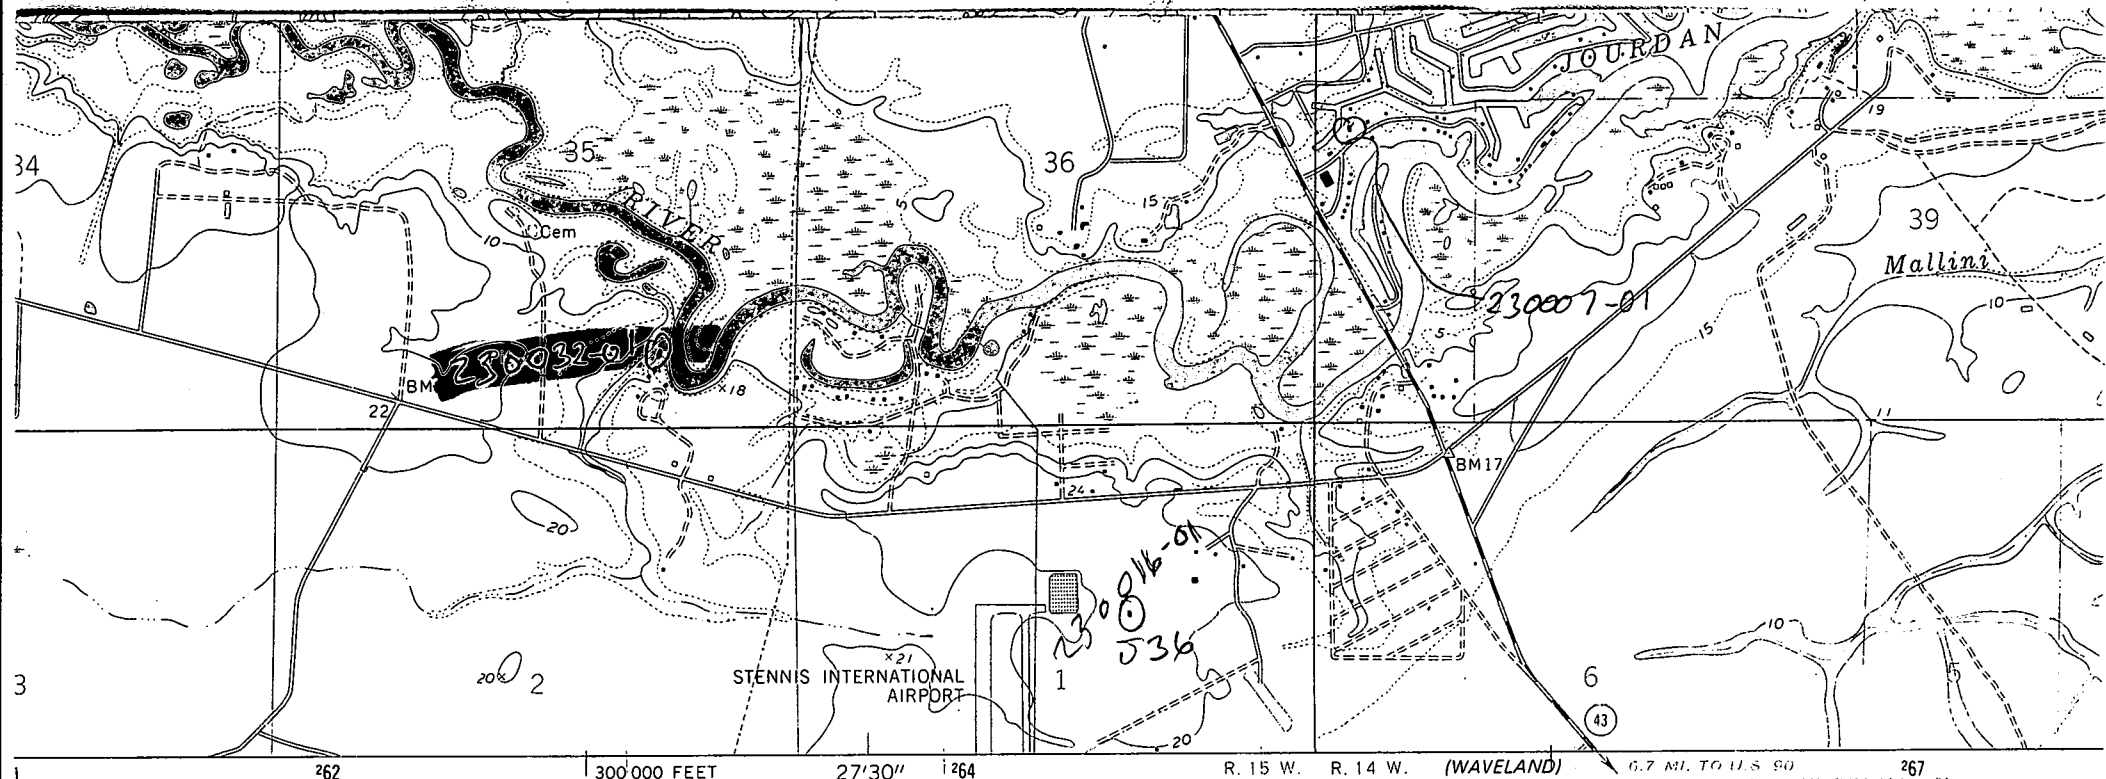


The Geological Survey

Photogrammetric methods
Aerial photographs taken 1954

North datum
Plane system, east zone
Grid ticks,


Aerial photographs
Not field checked

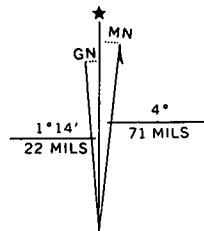

UTM GRID AND 1976 MAGNETIC NORTH
DECLINATION AT CENTER OF SHEET

1 262 300 000 FEET 27'30" 264 R. 15 W. R. 14 W. (WAVELAND) 3144 IV SW 0.7 MI. TO U.S. 90 267 BAY ST. LOUIS 10 MI. (VIA U.S. 90)

SCALE 1:24 000

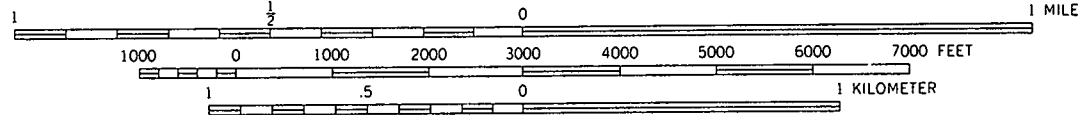

CONTOUR INTERVAL 10 FEET
DOTTED LINES REPRESENT 5-FOOT CONTOURS
NATIONAL GEODETIC VERTICAL DATUM OF 1929

THIS MAP COMPLIES WITH NATIONAL MAP ACCURACY STANDARDS
FOR SALE BY U. S. GEOLOGICAL SURVEY
DENVER, COLORADO 80225, OR RESTON, VIRGINIA 22092
A FOLDER DESCRIBING TOPOGRAPHIC MAPS AND SYMBOLS IS AVAILABLE ON REQUEST