

9-185
(October 1950)

UNITED STATES
DEPARTMENT OF THE INTERIOR
GEOLOGICAL SURVEY
WATER RESOURCES DIVISION

WELL SCHEDULE

Date 4/25, 1962 Field No. 638
Record by B. E. W. Office No. F28
Source of data _____

1. Location: State _____ County Hampshire

Map SE 1/4 SW 1/4 sec. 18 T 15 N R 3 E W

2. Owner: James A. ... Address _____

Tenant _____ Address _____

Driller _____ Address _____

3. Topography _____

4. Elevation 105 ft. above topo below _____

5. Type: Dug, drilled, driven, bored, jetted _____

6. Depth: Rept. _____ ft. Meas. _____ ft.

7. Casing: Diam. 18 in., to _____ in., Type _____

8. Chief Aquifer alluvium From _____ ft. to _____ ft.

Others _____

9. Water level 14.65 ft. rept. 4/25 1962 above 3.0 below top of casing which is 3.0 ft. above surface

10. Pump: Type turbine Capacity _____ G. M.

Power: Kind Carloss well supply co. Horsepower 50

11. Yield: Flow _____ G. M. Pump _____ G. M., Meas., Rept. Est.

Drawdown _____ ft. after _____ hours pumping _____ G. M.

12. Use: Dom., Stock, PS., RR., Ind., Irr., Obs. _____


Adequacy, permanence _____

13. Quality _____ Temp _____ °F.

Taste, odor, color _____ Sample Yes No

Unfit for _____

14. Remarks: (Log, Analyses, etc.) _____

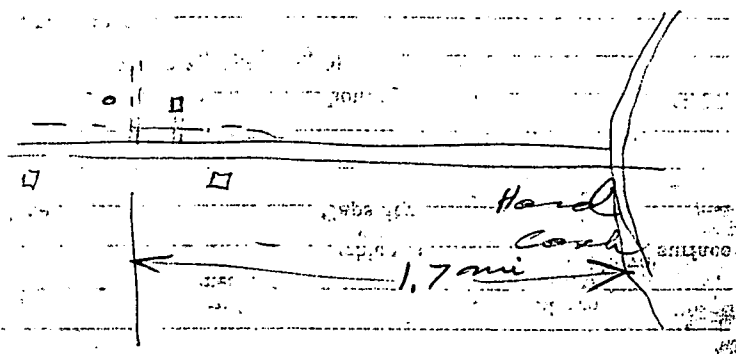

25.00
 3.95
~~21.05~~
 3.00
 2-2-65
 18.05
 MP TOP CASING
 3.0 above Lsol

60-26.8
 from end of
 8" pipe
 10-20-65

5/14/65

6-9-65

25.0
 4.2
~~20.8~~
 3.0
 17.8

22.00
 3.00
 19.00




Bellewood Quad

9114
F42

27 (MIDNIGHT) 285 11 SE R. 4 W. . R. 3 W.

SCALE 1:24 000

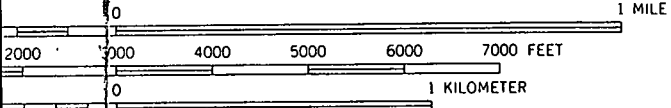

CONTOUR INTERVAL 5 FEET
ELEVATION IS MEAN SEA LEVEL

731000m E INTERIOR-GEOLGICAL
SILVER CITY 2.3 MI.
YAZOO CITY 28 MI.

ROAD (

Heavy-duty

Medium-duty

U. S. Route



QUADRANGLE LOCATION

WITH NATIONAL MAP ACCURACY STANDARDS