

MISSISSIPPI DEPARTMENT OF NATURAL RESOURCES

Bureau of Land and Water Resources

P.O. Box 10631

Jackson, Mississippi 39209

WATER WELL DRILLERS LOG

COUNTY WELL LOCATED
Amite

WELL NUMBER
M 2027

CODED

DATE WELL COMPLETED
Apr 19-90

PERMIT NUMBER

NAME OF DRILLING FIRM
F. T. GERALD Well Sew

NAME & MAILING ADDRESS OF LANDOWNER
James Stevenson
R.R. Liberty Ms.

WELL LOCATION: SEC 3 TOWNSHIP 2 RANGE N 3 E
S 3 W

DISTANCE 8 Miles DIRECTION W of NEAREST TOWN Liberty

OTHER LANDMARK

WELL PURPOSE: Home, Irrigation, Municipal, Industrial, Fish Pond, etc.
Home

PUMP DATA

PUMP TYPE (Circle One):
 Submersible, Turbine, Jet, Flowing Well,
Other (Describe) _____

POWER TYPE (Circle One):
 Electric, Tractor, Diesel, Gasoline, Butane,
Other (Describe) _____ H/P _____

Pump Capacity (GPM) 10 No. of Stages 9 Setting Depth 85 FT.

PUMP TEST
Well yielded 15 GPM with
a drawdown of 2 ft.
after 2 hours of pumping

WELL DATA

Well Depth <u>100</u>	Casing Diameter (In.) <u>4</u>	Casing Length (Ft.) <u>90</u>
Type of Casing <u>PVC</u>	Hole Depth <u>100</u>	Depth to Static Water Level <u>50</u>

TYPE OF COMPLETION: (Circle One or More):
 Gravel Packed, Underreamed, Telescoped,
 Natural Development, Open Hole, Other _____

Top of Lap Pipe or Reduction in Casing
FEET IF TELESCOPED OR MORE THAN ONE SCREEN: USE BACK PAGE

LOG DATA

TYPE OF LOG RUN (Circle One):
 No Log Run, Electric, Gamma Ray, Density, Sonic, Neutron,
Other (Describe) _____

Name of Organization Running Log

SCREEN DATA

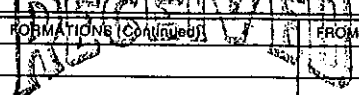
Diameter - Inches <u>4</u>	Length - Feet <u>10</u>	Slot Size - Inches <u>.014</u>
Screen Type <u>PVC</u>	Depth to Bottom - Feet <u>100</u>	

GEOLOGIC DATA (Office Use Only)

Surface Elev.	Geologic Unit	Unit Thickness	Depth to Top
Subs. SWL	Date	Analysis	Aquifer Test

Driller's Remarks

DESCRIPTION OF FORMATIONS ENCOUNTERED	FROM	TO	FORMATIONS (CONTINUED)	FROM	TO
<i>Red clay</i>	<i>0</i>	<i>10</i>			
<i>Red Sand</i>	<i>10</i>	<i>85</i>			
<i>Coarse Sand & gravel</i>	<i>85</i>	<i>100</i>			


 MAY 11 1990
 Department of Natural Resources
 Bureau of Land & Water Resources

IF MORE SPACE IS NEEDED, USE BACK