

#3

STATE WELL REPORT

317

County: Amite
 Permit #: _____
 Driller: Fitzgerald Well Service
 Date drilling completed: 9-17-18

**Part 1
Driller's Log**
 Mississippi Department of Environmental Quality
 Office of Land and Water Resources
 P.O. Box 2309
 Jackson, MS 39225-2309
 (601)961-5555
 (601)961-5228 (fax)

For Office Use Only:
 Well #: U1140
 Aquifer: _____
 E-Log #: _____

State Law requires that this report be prepared by the license holder responsible for the work and filed with the Department at the above address within 30 days of completion of drilling of the well or borehole.

Well Owner Information (Landowner if borehole is not for a water well) Owner Name: <u>Russ Reeves</u> Mailing Address: <u>Hwy 564</u> <u>Gilburg</u> MS Zip Code _____ City State Telephone No. (____) _____		Well or Borehole Location Latitude: <u>31° 4' 54.1"</u> Longitude: <u>90° 36' 10.4"</u> Method of Lat/Long (check one): Conventional Survey _____, USGS quad _____, Hand-held GPS _____, Survey-grade GPS _____ <u>SE 1/4 NE 1/4, Sec 4 T1N R6E</u> _____ Miles _____ of _____ (Distance) (Direction) (Nearest Town)
---	--	---

Well / Borehole Data
 Date drilling started: 9-17-18 Date drilling completed: 9-17-18 Hole depth: 68' Hole diameter: 8"
 Location of the source of any surface water used for drilling: _____
 Method of dosing and volume of Chlorine used in drilling and development: _____
 Logs run (check all applicable): Log run Electric Gamma Ray Density Sonic Neutron Other: _____
 Name of organization running log(s): _____
 Purpose of borehole (check one): Water Well Geotechnical/Geological Investigation Ground Source Heat Pump
 Seismic Survey Other (describe) _____

If drilling is not related to water well construction, skip the remainder of this block

RECEIVED
 DEC 2 2018
 BY OLWR

Purpose of Well (check all applicable): Home Industrial Public Supply Irrigation Fish Culture
 Other (describe): Poultry House
 If a flowing well, method of flow regulation: Valve _____ Other (describe) _____
 Static Water Level: 20' feet above or below land surface Date measured: 9-17-18
 (check one)
 Method of measurement (check one) Steel tape Electric tape Air line Other (describe): _____
 Well depth: 68' Well grouted to a depth of: 40' feet Type of grout (check one) Neat Cement Bentonite Mix
 Casing length: 48' feet Casing diameter: 4" inches Type of casing: Pvc
 Screen length: 20' feet Screen diameter: 4" inches Type of screen: Pvc
 Screen slot size: 010 inches Setting depth: From 48' feet to 68' feet
 Type of completion (check all applicable) Gravel packed Underreamed Open hole Natural Development
 Other (describe): _____
 Top of lap pipe or reduction in casing: _____ feet

If telescoped or more than one screen, describe on next page

County: _____


Permit #: _____

For Office Use Only:

Well #: U140

The sketch below only required for water wells

If well telescopes, show depths on sketch.

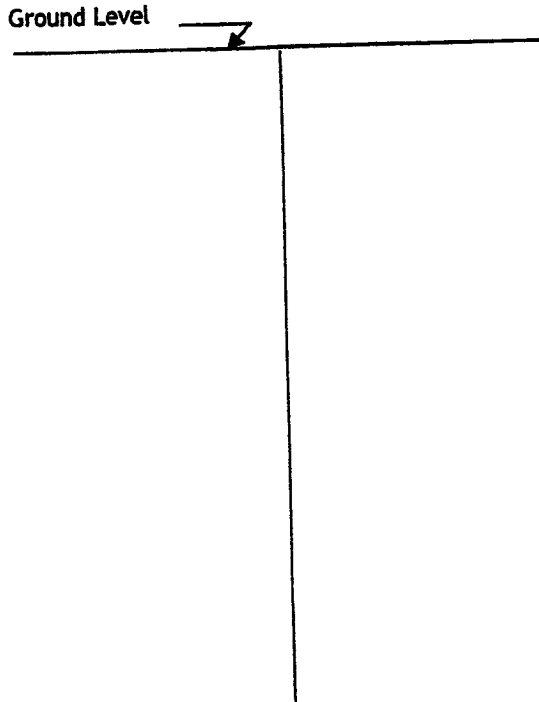

Description of formations encountered must be provided for all wells and boreholes, unless specifically exempted by regulations

Description of Formations Encountered	From (depth)	To (depth)
	Ground level	
clay	0	20
gravel	20	40
course sand	40	60

If more than one screen, show location of each on sketch

- Sketch the property layout and include the following:
- 1) the well location
 - 2) any permanent structures on the property that may aid in locating the well
 - 3) any roads, power lines, or other items that may aid in locating the property and the well
 - 4) north arrow


Landowner Name: Russ Reeves

I HEREBY CERTIFY that the well/borehole was drilled, constructed, and completed in accordance with all applicable requirements of the Mississippi Department of Environmental Quality and the Mississippi Department of Health regulations, if applicable, and state laws.


Brad Fitzgerald 029 9-15-18 [Signature]
Print Name of Responsible Licensee and License No. Date Signature of Licensee

U1A0

Google Maps 31°04'54.1"N 90°36'10.4"W

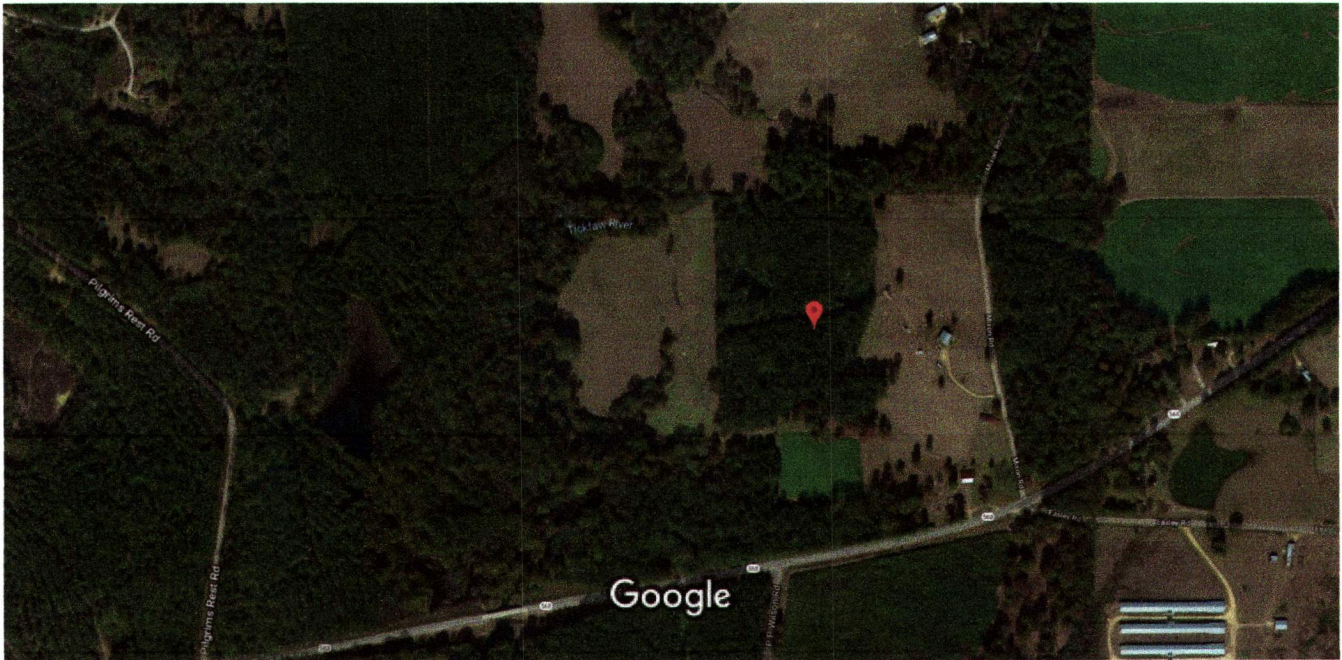

Imagery ©2018 Google, Map data ©2018 Google 200 ft

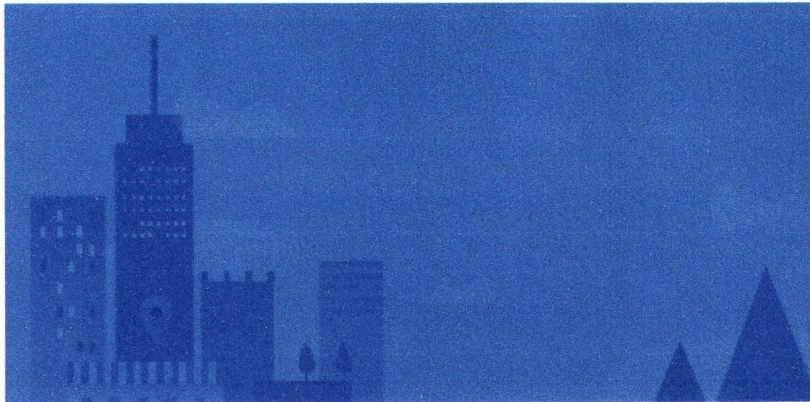

31°04'54.1"N 90°36'10.4"W
31.081702, -90.602901

RECEIVED
DEC 21 2018
BY OLWR

NA, MS

39JW+MR Gillsburg, Mississippi

#3

Russ Reeves
9-17-18

68'
20'
50'
1 1/2 HP

#3.

STATE WELL REPORT

Part 2

Pump Installer's Completion Report

Mississippi Department of Environmental Quality
Office of Land and Water Resources

P.O. Box 2309
Jackson, MS 39225-2309

(601)961-5210
(601) 360-0535 (fax)

County: Amite
 Permit #: _____
 Driller: Fitzgerald Well Saver
 Date completed: 9-17-18
Copy information from block on Part 1

For Office Use Only:
 Well #: U140
 Aquifer: _____

This part of the report must be completed by a licensed water well contractor or a licensed pump installer. A copy of Part 1 of the report must be attached and both parts filed with the Department at the above address within 30 days of well completion.

Well Owner Information			Well Location	
Owner Name: <u>Russ Reeves</u>	Latitude: <u>31°4'54.1"</u> Longitude: <u>90°36'10.4"</u>			
Mailing Address: <u>Hwy 568</u>	Method of Lat/Long (check one): Conventional Survey _____			
	USGS quad _____, Hand-held GPS _____, Survey-grade GPS _____			
<u>Giltsburg</u> City	<u>MS</u> State	<u>SE 1/4 NE 1/4, Sec 4 T1N R6E</u>		
Telephone No. (____) _____	Zip Code _____	_____ Miles _____ of _____	(Distance) (Direction) (Nearest Town)	

Pump Type (check one)
 Submersible Turbine Air Lift Centrifugal Flowing Well Jet Piston Rotary Other (describe): _____
 Date Pump Installed: 9-17-18 Rated Pump Capacity: 25 Gallons Per Minute
 Is This Pump (check one): New Repaired Replacement

Power Type (check one)
 Electric Diesel Gasoline Natural Gas Tractor PTO Windmill Other (describe): _____
 Horse Power Rating of Motor: 1 1/2 Setting Depth: 50' feet Number of Stages: _____

Pump Test Data for Non Flowing Well
 Date Well Tested: _____ Duration of Pump Test (minimum 4 hours): _____ hours
 Static Water Level (A): _____ Feet Below Land Surface Pumping Water Level (B): _____ Feet Below Land Surface
 Drawdown [(B) - (A)]: _____ Feet Below Land Surface Test Pumping Rate: _____ Gallons Per Minute
 Method of measurement (check one): Steel tape Electric tape Air line Other (describe): _____

Pump Test Data for Flowing Well
 Measured shut in head: _____ feet.
 Well yielded _____ GPM with a drawdown of _____ feet after _____ hours of pumping

Meter Installation
 Meter Manufacturer: _____ Meter Serial Number: RECEIVED
 Meter Model Number/Name: _____ Type of Meter: _____
 Totalizer Register Unit and Multiplier Factor (AF x .001, gal x 1000, etc): _____ DEC 21 2018
 Installation Date: _____ Meter installed by: _____ BY OLWR
 Is This Meter (check one): New Repaired Replacement
Important: By submitting the above information you are certifying that this meter was installed to manufacturer standards. For agricultural wells, a list of approved meters is on the MDEQ website.

I HEREBY CERTIFY that the above statements are true to the best of my knowledge.
Brad Fitzgerald 029 9-17-18 [Signature]
 Print Name of Pump Installer and License No. (if applicable) Date Signature of Pump Installer