

May 24 05 07:58a

Mid-South Water

(662)843-1717

P. 2

State Well Report

Part 1

Mississippi Department of Environmental Quality
 Office of Land and Water Resources
 P.O. Box 10631
 Jackson, MS 39289-0631
 (601)961-5210
 (601)354-6938 (fax)

For Office Use Only:

Aquifer: _____
 Well #: F-205
 L. S. Elevation: _____
 E-log #: _____

County: Bolivar
 Permit #: 40190
 Driller: Mike Wells
 Date drilling completed: 5/19/05

State Law requires that this report be prepared by the driller in detail and filed with the Department within 30 days of completion of drilling of the well.

Well Owner Information	Well Location
Owner Name: <u>C.T. Dana Farm</u>	Latitude: <u>33° 51' 11"</u> Longitude: <u>90° 55' 33"</u>
Mailing Address: <u>469 Dattell Road</u>	Method of Lat/Long (circle one): Conventional Survey, USGS quad, Hand-held GPS, Survey-grade GPS
<u>Rosedale, MS 38769</u> City State Zip Code	<u>SW 1/4 SE 1/4 Sec 15 Twn 23N Rng 7W</u>
Telephone No. <u>(662) 721-7369</u>	Distance <u>3/4</u> Miles Direction <u>W</u> of Nearest Town <u>Malvina</u>

Well Data

Purpose of Well (circle one) Home Industrial Public Supply Irrigation Fish Culture Other: _____

Date well drilling started: 5/19/05 Date well drilling completed: 5/19/05

If flowing, method of flow regulation: Valve N/A Other (describe) _____

Static Water Level: 36 feet above or below (circle one) land surface Date measured: 5/19/05

Method of Measurement (circle one) steel tape electric tape air line other: _____

Hole depth: 133' Well depth: 133' Well grouted to a depth of 10 feet

Type of grout (circle one): Cement Bentonite Mix

Casing length: 83 feet Casing diameter: 16 inches Type of casing: PVC

Screen length: 50 feet Screen diameter: 16 inches Type of screen: PVC

Screen slot size: .050 inches Setting depth: From 83 feet to 133 feet

Type of completion (circle all applicable): Gravel packed Underreamed Telescoped Open hole Natural Development
 Other (describe): _____


Top of lap pipe or reduction in casing: N/A feet. If telescoped or more than one screen, describe on back of page

Logs run (circle all applicable): No log run Electric Gamma Ray Density Sonic Neutron Other: _____

Name of organization running log(s): N/A

I certify that the well was drilled, constructed, and completed in accordance with all applicable requirements of the Mississippi Department of Environmental Quality and/or the Mississippi Department of Health regulations and state laws.

Thomas G. Chrestman 0-703

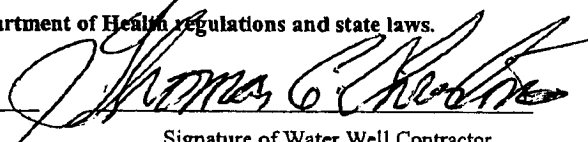

Print Name of Water Well Contractor and License No.

Signature of Water Well Contractor

May 24 05 07:58a

Mid-South Water

(662)843-1717


p. 3

40190

If well telescopes please sketch below and show depths.

F-205

Ground Level

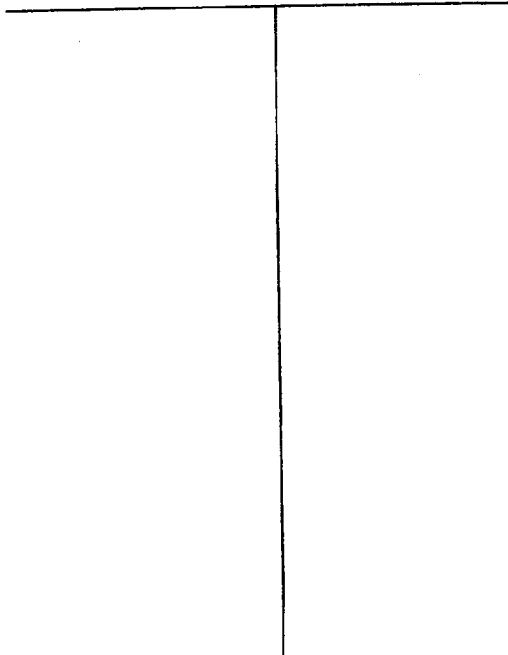

Description of Formations Encountered	From	To
Clay	0	24
Streaks of Fine Sand & Lignite	24	34
Medium Sand	34	44
Medium Sand & Gravel	44	54
Coarse Sand & Gravel	54	88
Medium Sand	88	90
Coarse Sand & Gravel	90	120
Coarse Sand	120	133

If more than one screen, show location of each on sketch

Sketch the property layout and include the following: 1) the well location; 2) any permanent structures on the property that may aid in locating the well; 3) any roads, power lines, or other items that may aid in locating the property and the well; 4) indicate direction.

Well # 8 West

M. H. ...

3/4 mile

* REPLACES EXISTING WELL LOCATED 15' FROM NEW WELL

Landowner Name C. T. Ann

Thomas G. ...
Signature of Water Well Contractor

May 30 05 03:17p

Mid-South Water

(662)843-1717

p. 3

STATE WELL REPORT

Part 2

County: Bolivar
 Permit #: 440190
 Driller: Mike Wells
 Date completed: 5/19/05

Pump Installer's Completion Report
 Mississippi Department of Environmental Quality
 Office of Land and Water Resources
 P.O. Box 10631
 Jackson, MS 39289-0631
 (601)961-5210
 (601)354-6938 (fax)

For Office Use Only:
 Aquifer: _____
 Well #: F-205
 Elevation: _____

This report should be prepared by the pump installer in detail and filed with the Department within 30 days of the installation of pump.

Well Owner Information	Well Location
Owner Name: <u>C.T. Dana Farm</u>	Latitude: _____ Longitude: _____
Mailing Address: <u>469 Dattell Road</u>	Method of Lat/Long (circle one): Conventional Survey, USGS quad, Hand-held GPS, Survey-grade GPS
<u>Rosedale, MS 38769</u>	<u>1/4</u> <u>1/4</u> Sec <u>15</u> Twn <u>23N</u> Rng <u>7W</u>
City State Zip Code	Distance Direction Nearest Town
Telephone No. (tele 2) <u>721-7369</u>	<u>3/4</u> Miles <u>W</u> of <u>Malvina</u>

Pump Type Circle one	Power Type Circle one
Air Lift Jet <input type="radio"/> Submersible <input type="radio"/>	<input checked="" type="radio"/> Diesel Engine Gasoline Engine Natural Gas
Bucket Piston <input type="radio"/> Turbine <input checked="" type="radio"/>	Electric Motor Hand Tractor PTO
Centrifugal Rotary <input type="radio"/> Flowing Well <input type="radio"/>	Windmill Other (specify): _____
Other (specify): _____	Horse Power Rating of Motor: <u>N/A</u>
Date Pump Installed: <u>5/24/05</u>	Setting Depth: <u>70</u> feet
Rated Pump Capacity: <u>2,000</u> Gallons Per Minute	Number of Stages: <u>1</u>

Pump Test Data	Method of Measuring Water Level Circle one
Date Well Tested: <u>Not Tested</u>	Air Line Electric Measuring Line <input checked="" type="radio"/> Steel Tape
Static Water Level (A): <u>36</u> Feet Below Land Surface	Other (specify): _____
Pumping Water Level (B): <u>N/A</u> Feet Below Land Surface	For flowing well, measured shut in head: <u>N/A</u> feet
Drawdown [(B) - (A)]: <u>N/A</u> Feet Below Land Surface	Well yielded <u>N/A</u> GPM with a drawdown of _____ feet after _____ hours of pumping
Test Pumping Rate: <u>N/A</u> Gallons Per Minute	
Duration of Pump Test (minimum 4 hours): <u>N/A</u> hours	

I HEREBY CERTIFY that the above statements are true to the best of my knowledge.

Thomas G. Chrestman 0-703 _____
 Print Name of Pump Installer and License No. (if applicable) Signature of Pump Installer