

County: Bolivar
 Permit #: GW 45469
 Irrigation Equipment
 Driller: _____
 Date drilling completed: 8-1-11

State Well Report
Part 1 - Driller's Log
 Mississippi Department of Environmental Quality
 Office of Land and Water Resources
 P.O. Box 2309
 Jackson, MS 39225
 (601)961- 5210
 (601)961- 5228 (fax)

For Office Use Only:
 Aquifer: M 252
 Well #: _____
 L. S. Elevation: _____
 E-log #: _____

State Law requires that this report be prepared by the license holder responsible for the work and filed with the Department at the above address within 30 days of completion of drilling of the well or borehole.

<p>Information on Well Owner (Landowner if borehole is not for a water well)</p> <p>Owner Name <u>John Abide</u></p> <p>Mailing Address: <u>Box 489</u> <u>Cleveland MS 38732</u> City State Zip Code</p> <p>Telephone No. () _____</p>	<p>Well or Borehole Location</p> <p>Latitude: <u>33° 46' 48.5"</u> Longitude: <u>90° 42' 13.0"</u></p> <p>Method of Lat/Long (circle one): Conventional Survey, USGS quad, <u>(Hand-held GPS)</u>, Survey-grade GPS</p> <p><u>SE 1/4 SW 1/4 Sec 3</u> Twn <u>22N</u> Rng <u>5W</u></p> <p>Distance Direction Nearest Town <u>1</u> Miles <u>NE</u> of <u>Cleveland</u></p>
--	---

Well / Borehole Data

Date drilling started: 8-1-11 Date drilling completed: 8-1-11 Hole depth: 124 Hole diameter: 24"

Location of the source of any surface water used for drilling: Surface Water
 Method of dosing and volume of Chlorine used in drilling and development: 50 PPM

Logs run (circle all applicable): (No log run) Electric Gamma Ray Density Sonic Neutron Other: _____
 Name of organization running log(s): _____

Purpose of borehole (check one): Water Well Geotechnical/Geological Investigation _____ Ground Source Heat Pump _____
 Seismic Survey _____ Other (describe) _____

If drilling is not related to water well construction, skip the remainder of this block

Purpose of Well (check one): Home _____ Industrial _____ Public Supply _____ Irrigation Fish Culture _____ Other: Replacement

If a flowing well, method of flow regulation: Valve _____ Other (describe) _____

Static Water Level: 47 feet above or (below) (circle one) land surface Date measured: 8-1-11

Method of Measurement (circle one) (steel tape) electric tape air line other: _____

Well depth: 124 Well grouted to a depth of 10 feet Type of grout (circle one): Neat Cement (Bentonite) Mix

Casing length: 84 feet Casing diameter: 16 inches Type of casing: PVC

Screen length: 40 feet Screen diameter: 16 inches Type of screen: PVC

Screen slot size: .050 inches Setting depth: From 85 feet to 124 feet

Type of completion (circle all applicable): (Gravel packed) Underreamed Telescoped Open hole Natural Development
 Other (describe): _____

Top of lap pipe or reduction in casing: _____ feet. *If telescoped or more than one screen, describe on next page*

Old Well 12" Steel 250' South

Form: OLWR-SWR-1A (04/08)

Applicant:
 Boone Farms
 1312 Memorial Dr.
 Cleveland MS 38732

CAB- 5/7/12

RECEIVED
 2011
 MISSISSIPPI DEPARTMENT OF ENVIRONMENTAL QUALITY

The sketch below only required for water wells

If well telescopes, show depths on sketch

Ground Level →

Description of formations encountered must be provided for all wells and boreholes, unless specifically exempted by regulations

Description of Formations Encountered	From (depth)	To (depth)
Clay	Ground Level	54
Medium Sand & Gravel	55	121
Clay	122	124

If more than one screen, show location of each on sketch

Sketch the property layout and include the following: 1) the well location; 2) any permanent structures on the property that may aid in locating the well; 3) any roads, power lines, or other items that may aid in locating the property and the well; 4) a north arrow.

Landowner Name: Roy Boone

Form: OLWR-SWR-1A (04/08)


I certify that the well/borehole was drilled, constructed, and completed in accordance with all applicable requirements of the Mississippi Department of Environmental Quality and the Mississippi Department of Health regulations, if applicable, and state laws.

Patrick M. Chism 0695

Print Name of Responsible Licensee and License No.

Date

Signature of Licensee

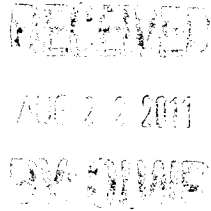

County: Bolivar
 Permit #: GW 45469
Irrigation Equipment
 Driller: _____
 Date completed: 8-1-11
Copy information from block on Part 1

STATE WELL REPORT

Part 2

Pump Installer's Completion Report
 Mississippi Department of Environmental Quality
 Office of Land and Water Resources
 P.O. Box 2309
 Jackson, MS 39225
 (601)961-5210
 (601)961-5228 (fax)

For Office Use Only:
 Aquifer: _____
 Well #: M252
 Elevation: _____

This part of the report must be completed by a licensed water well contractor or a licensed pump installer. A copy of Part 1 of the report must be attached and both parts filed with the Department at the above address within 30 days of well completion.


Well Owner Information	Well Location
Owner Name: <u>John Abide</u>	Latitude: _____ Longitude: _____
Mailing Address: <u>Box 489</u>	Method of Lat/Long (check one): Conventional Survey _____
<u>cleveland MS 38732</u>	USGS quad _____, Hand-held GPS <input checked="" type="checkbox"/> , Survey-grade GPS _____
City State Zip Code	<u>SE 1/4 SW 1/4 Sec 3 T.22N R.5W</u>
Telephone No. () _____	Distance _____ Miles Direction <u>NE</u> of Nearest/Town <u>Cleveland</u>

Pump Type	Power Type
Circle one	Circle one
Air Lift <input type="checkbox"/> Jet <input type="checkbox"/> Submersible <input type="checkbox"/>	<u>Diesel Engine</u> <input checked="" type="checkbox"/> Gasoline Engine <input type="checkbox"/> Natural Gas <input type="checkbox"/>
Bucket <input type="checkbox"/> Piston <input type="checkbox"/> <u>Turbine</u> <input checked="" type="checkbox"/>	Electric Motor <input type="checkbox"/> Hand <input checked="" type="checkbox"/> Tractor PTO <input type="checkbox"/>
Centrifugal <input type="checkbox"/> Rotary <input type="checkbox"/> Flowing Well <input type="checkbox"/>	Windmill <input type="checkbox"/> Other (specify): _____
Other (specify): _____	Horse Power Rating of Motor: <u>40</u>
Date Pump Installed: <u>8-1-11</u>	Setting Depth: <u>70</u> feet
Rated Pump Capacity: <u>1200[±]</u> Gallons Per Minute	Number of Stages: <u>2</u>

Pump Test Data	Method of Measuring Water Level
Date Well Tested: _____	Circle one
Static Water Level (A): _____ Feet Below Land Surface	Air Line <input type="checkbox"/> Electric Measuring Line <input type="checkbox"/> Steel Tape <input type="checkbox"/>
Pumping Water Level (B): _____ Feet Below Land Surface	Other (specify): _____
Drawdown [(B) - (A)]: _____ Feet Below Land Surface	For flowing well, measured shut in head: _____ feet
Test Pumping Rate: _____ Gallons Per Minute	Well yielded _____ GPM with a drawdown of _____ feet after _____ hours of pumping
Duration of Pump Test (minimum 4 hours): _____ hours	

This is for (circle one): New Well Replacement of Existing Pump Repair of Existing Pump

I HEREBY CERTIFY that the above statements are true to the best of my knowledge.
 Patrick M. Chism 0695
 Print Name of Pump Installer and License No. (if applicable) _____ Signature of Pump Installer _____

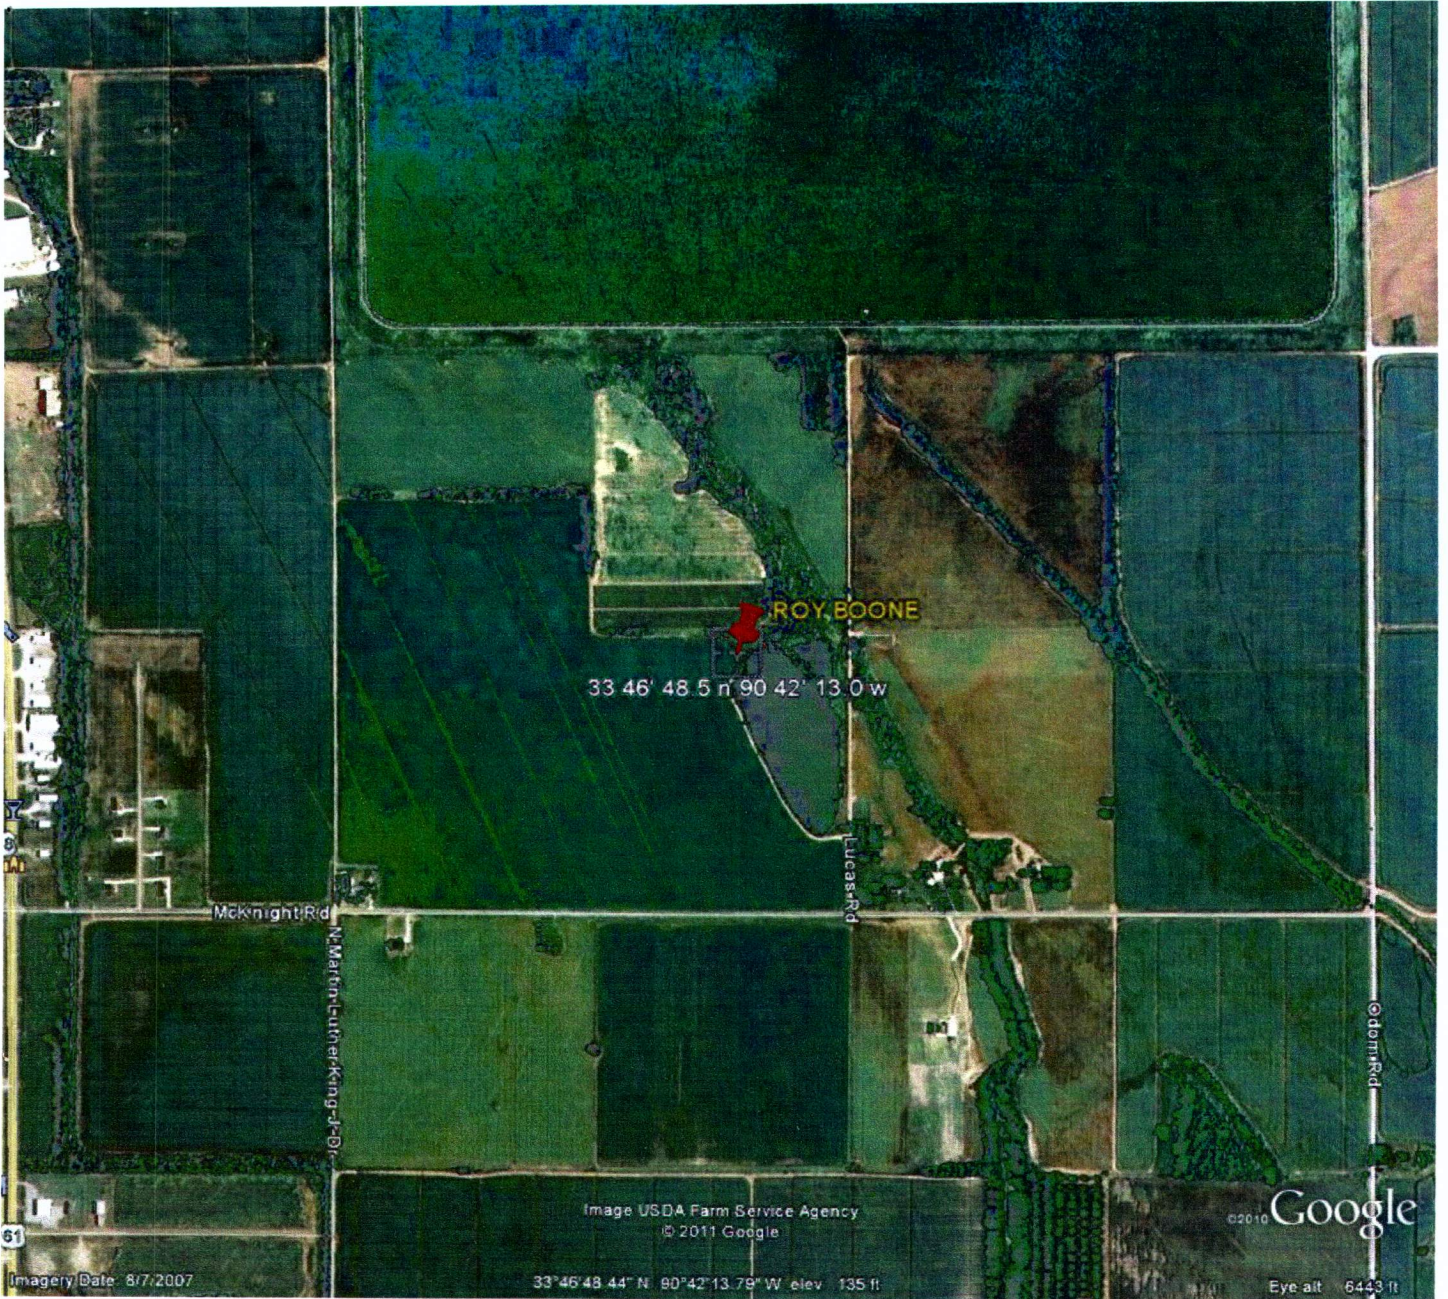

RECEIVED
AUG 22 2011
BY: OLWR