

MISSISSIPPI DEPARTMENT OF ENVIRONMENTAL QUALITY

Office of Land and Water Resources

P. O. Box 10631
Jackson, MS 39289-0631

WATER WELL DRILLERS LOG

COUNTY WELL LOCATED <i>Butler</i>	
WELL NUMBER <i>R 2043</i>	CODED
DATE WELL COMPLETED <i>76 July 88</i>	

PERMIT NUMBER
NAME OF DRILLING FIRM <i>Lambert Drilling</i>

NAME & MAILING ADDRESS OF LANDOWNER <i>Rufus Robinson</i> <i>hement, MS.</i>			
WELL LOCATION: SEC <i>207</i>	TOWNSHIP <i>20 S</i>	RANGE <i>9 E</i>	
DISTANCE <i>10</i> Miles	DIRECTION <i>N</i>	NEAREST TOWN <i>Greenville</i>	
OTHER LANDMARK <i>home</i>			
WELL PURPOSE: Home, Irrigation, Municipal, Industrial, Fish Pond, etc.			

PUMP DATA		
PUMP TYPE (Circle One): Submersible, Turbine, Jet, Flowing Well, Other (Describe) _____		
POWER TYPE (Circle One): Electric, Tractor, Diesel, Gasoline, Butane, Other (Describe) _____ H/P _____		
Pump Capacity (GPM) <i>20</i>	No. of Stages <i>8</i>	Setting Depth <i>120</i> FT.
PUMP TEST Well yielded _____ GPM with a drawdown of _____ ft. after _____ hours of pumping		

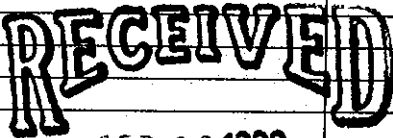
WELL DATA		
Well Depth <i>480</i>	Casing Diameter (In.) <i>4x2</i>	Casing Length (Ft.) <i>460</i>
Type of Casing <i>PVC</i>	Hole Depth <i>480</i>	Depth to Static Water Level <i>56</i>
TYPE OF COMPLETION: (Circle One or More): Gravel Packed, Underreamed, Telescoped, Natural Development, Open Hole, Other (Describe) _____		

LOG DATA	
TYPE OF LOG RUN (Circle One): No Log Run, Electric, Gamma Ray, Density, Sonic, Neutron, Other (Describe) _____	
Name of Organization Running Log	

WELL GROUTED TO A DEPTH OF _____ FEET Type Grout (circle one): Cement, Bentonite, or Mix

GEOLOGIC DATA (Office Use Only)			
Surface Elev.	Geologic Unit	Unit Thickness	Depth to Top
Subs. SWL	Date	Analysis	Aquifer Test
Driller's Remarks			

SCREEN DATA		
Diameter - Inches <i>2"</i>	Length - Feet <i>20</i>	Slot Size - Inches <i>10</i>
Screen Type <i>POC Vented</i>	Depth to Bottom - Feet <i>460-480</i>	

DESCRIPTION OF FORMATIONS ENCOUNTERED	FROM	TO	FORMATIONS (Continued)	FROM	TO
 SEP 09 1998 Dept. of Environmental Quality Office of Land & Water Resources					
IF MORE SPACE IS NEEDED, USE BACK					