

MISSISSIPPI DEPARTMENT OF ENVIRONMENTAL QUALITY
Office of Land and Water Resources
 P. O. Box 2309
 Jackson, MS 39225
Water Well Plugging/Decommissioning Form
 OLWR-DF-1 (04/08)

COUNTY WELL LOCATED: Clarke	WELL NUMBER: B17
PERMIT NUMBER:	DATE WELL PLUGGED: 12/22/14
NAME OF FIRM PLUGGING WELL: Walker-Hill Environmental	TELEPHONE NUMBER: 601-736-3500
NAME AND ADDRESS OF CURRENT LANDOWNER: Enterprise School Dist, 501 Short St. Enterprise, MS 39330	
WELL LOCATION: SECTION: 30 TOWNSHIP: 4N RANGE: 15E	
WELL LOCATION: LATITUDE: 32° 09' 49" LONGITUDE: 88° 48' 25"	METHOD (CIRCLE ONE): <u>(1) USGS QUAD</u> (2) CONVENTIONAL SURVEY (3) GPS - HAND HELD OR SURVEY GRADE
DISTANCE: 1 mile DIRECTION: SE NEAREST TOWN: Enterprise OTHER LANDMARK:	
WELL PURPOSE (HOME, IRRIGATION, MUNICIPAL, ETC.):	Supply for School
NAME OF WELL CONTRACTOR WHO DRILLED THE WELL:	Unknown
NAME OF LANDOWNER WHEN WELL WAS DRILLED:	Enterprise School

WELL DATA			
WELL DEPTH: 237	HOLE DEPTH:		
CASING DIAMETER (IN.): 4	CASING LENGTH (FT.): 168	TYPE OF CASING: Steel	
DEPTH TO STATIC WATER LEVEL: 70	DATE WELL COMPLETED: 9/60		
WHY IS THE WELL BEING ABANDONED? out of Service			

DESCRIBE HOW THE WELL OR HOLE WAS PLUGGED (AMOUNT OF CASING AND/OR SCREEN THAT WAS REMOVED OR LEFT IN HOLE, MATERIAL AND AMOUNT USED IN PLUGGING, METHOD OF PLACING MATERIAL, ETC.)

Pulled out the pump. trimie grout in-place with cement/bentonite grout slurry from bottom to top by trimie method. Cut well casing 2.5' below ground surface

I CERTIFY THAT THE WELL WAS PLUGGED OR ABANDONED IN ACCORDANCE WITH THE STATE OF MISSISSIPPI REGULATIONS.

Daren S. Bracey

Dan J. Bracey

SIGNATURE

0-522

MS LICENSE NUMBER

1/10/15

DATE

WRD Exp. (GW)
April, 1966

Well No. B17

WELL SCHEDULE

U. S. DEPT. OF THE INTERIOR

GEOLOGICAL SURVEY

WATER RESOURCES DIVISION

MASTER CARD

Record by B Source of data BWC Date 3 68 Map _____


Latitude: 3 2 0 9 4 5 N Longitude: 0 8 8 4 8 2 5 Sequential number: 1

Lat-long accuracy: 5 T. 40 S. R. 150 Sec 30

Local well number: 0 5 5 Other well number: _____

Local use: _____ Owner or name: ENTERPRISE Address: _____

Ownership: County, Fed Gov't, City, Corp or Co, Private, State Agency, Water Dist. C

Use of W Air cond, Bottling, Comm, Dewater, Power, Fire, Dom, Irr, Mad, Ind, P S, Rec, Water: 7

Use of W Anode, Drain, Seismic, Heat Res, Obs, Oil-gas, Recharge, Test, Unused, Withdraw, Waste, Destroyed

DATA AVAILABLE: Well data Freq. W/L meas.: Field aquifer char.

Hyd. lab. data: _____

Qual. water data; type: _____

Freq. sampling: _____ Pumpage inventory: yes no, period: _____

Aperture cards: _____

Log data: _____

Concrete slab
6x6' best
grout

WELL-DESCRIPTION CARD

SAME AS ON MASTER CARD Depth well: 237 Meas. 3

Depth cased; (first perf.) 168 Casing type: _____; Diam. in 4

Finish: porous gravel w. concrete, (perf.) (G) gravel w. (H) horiz. open (P) perf., screen, ad. pt., shored, open hole, other 5

Method (A) air bored, (B) cable, (C) dug, (D) hyd jetted, (E) air reverse trenching, (F) driven, (G) drive wash, (H) other H

Date Drilled: 9 6 0 Pump intake setting: _____ ft 36

Driller: Terry address _____

Lift (type): (A) air, (B) bucket, (C) cent, (D) jet, (E) multiple, (F) multiple, (G) none, (H) piston, (I) rot, (J) submerg, (K) turb, (L) other Deep

Power (type): diesel, elec, gas, gasoline, hand, gas, wind, H.P. Trans. of meter no.

Descrip. MP _____ ft below LSD. Alt. MP _____

Alt. LSD: _____ Accuracy: (source) _____

Water Level: _____ ft above MP; _____ ft below LSD 18 Accuracy: _____

Date meas: N 7 9 Yield: _____ gpm Method determined A


Drawdown: _____ ft Accuracy: _____ Pumping period _____ hrs

QUALITY OF WATER DATA: Iron _____ ppm Sulfate _____ ppm Chloride _____ ppm Hard. _____ ppm

Sp. Conduct _____ K x 10 Temp. _____ °F Date sampled _____

Taste, color, etc. _____

Well No. B17

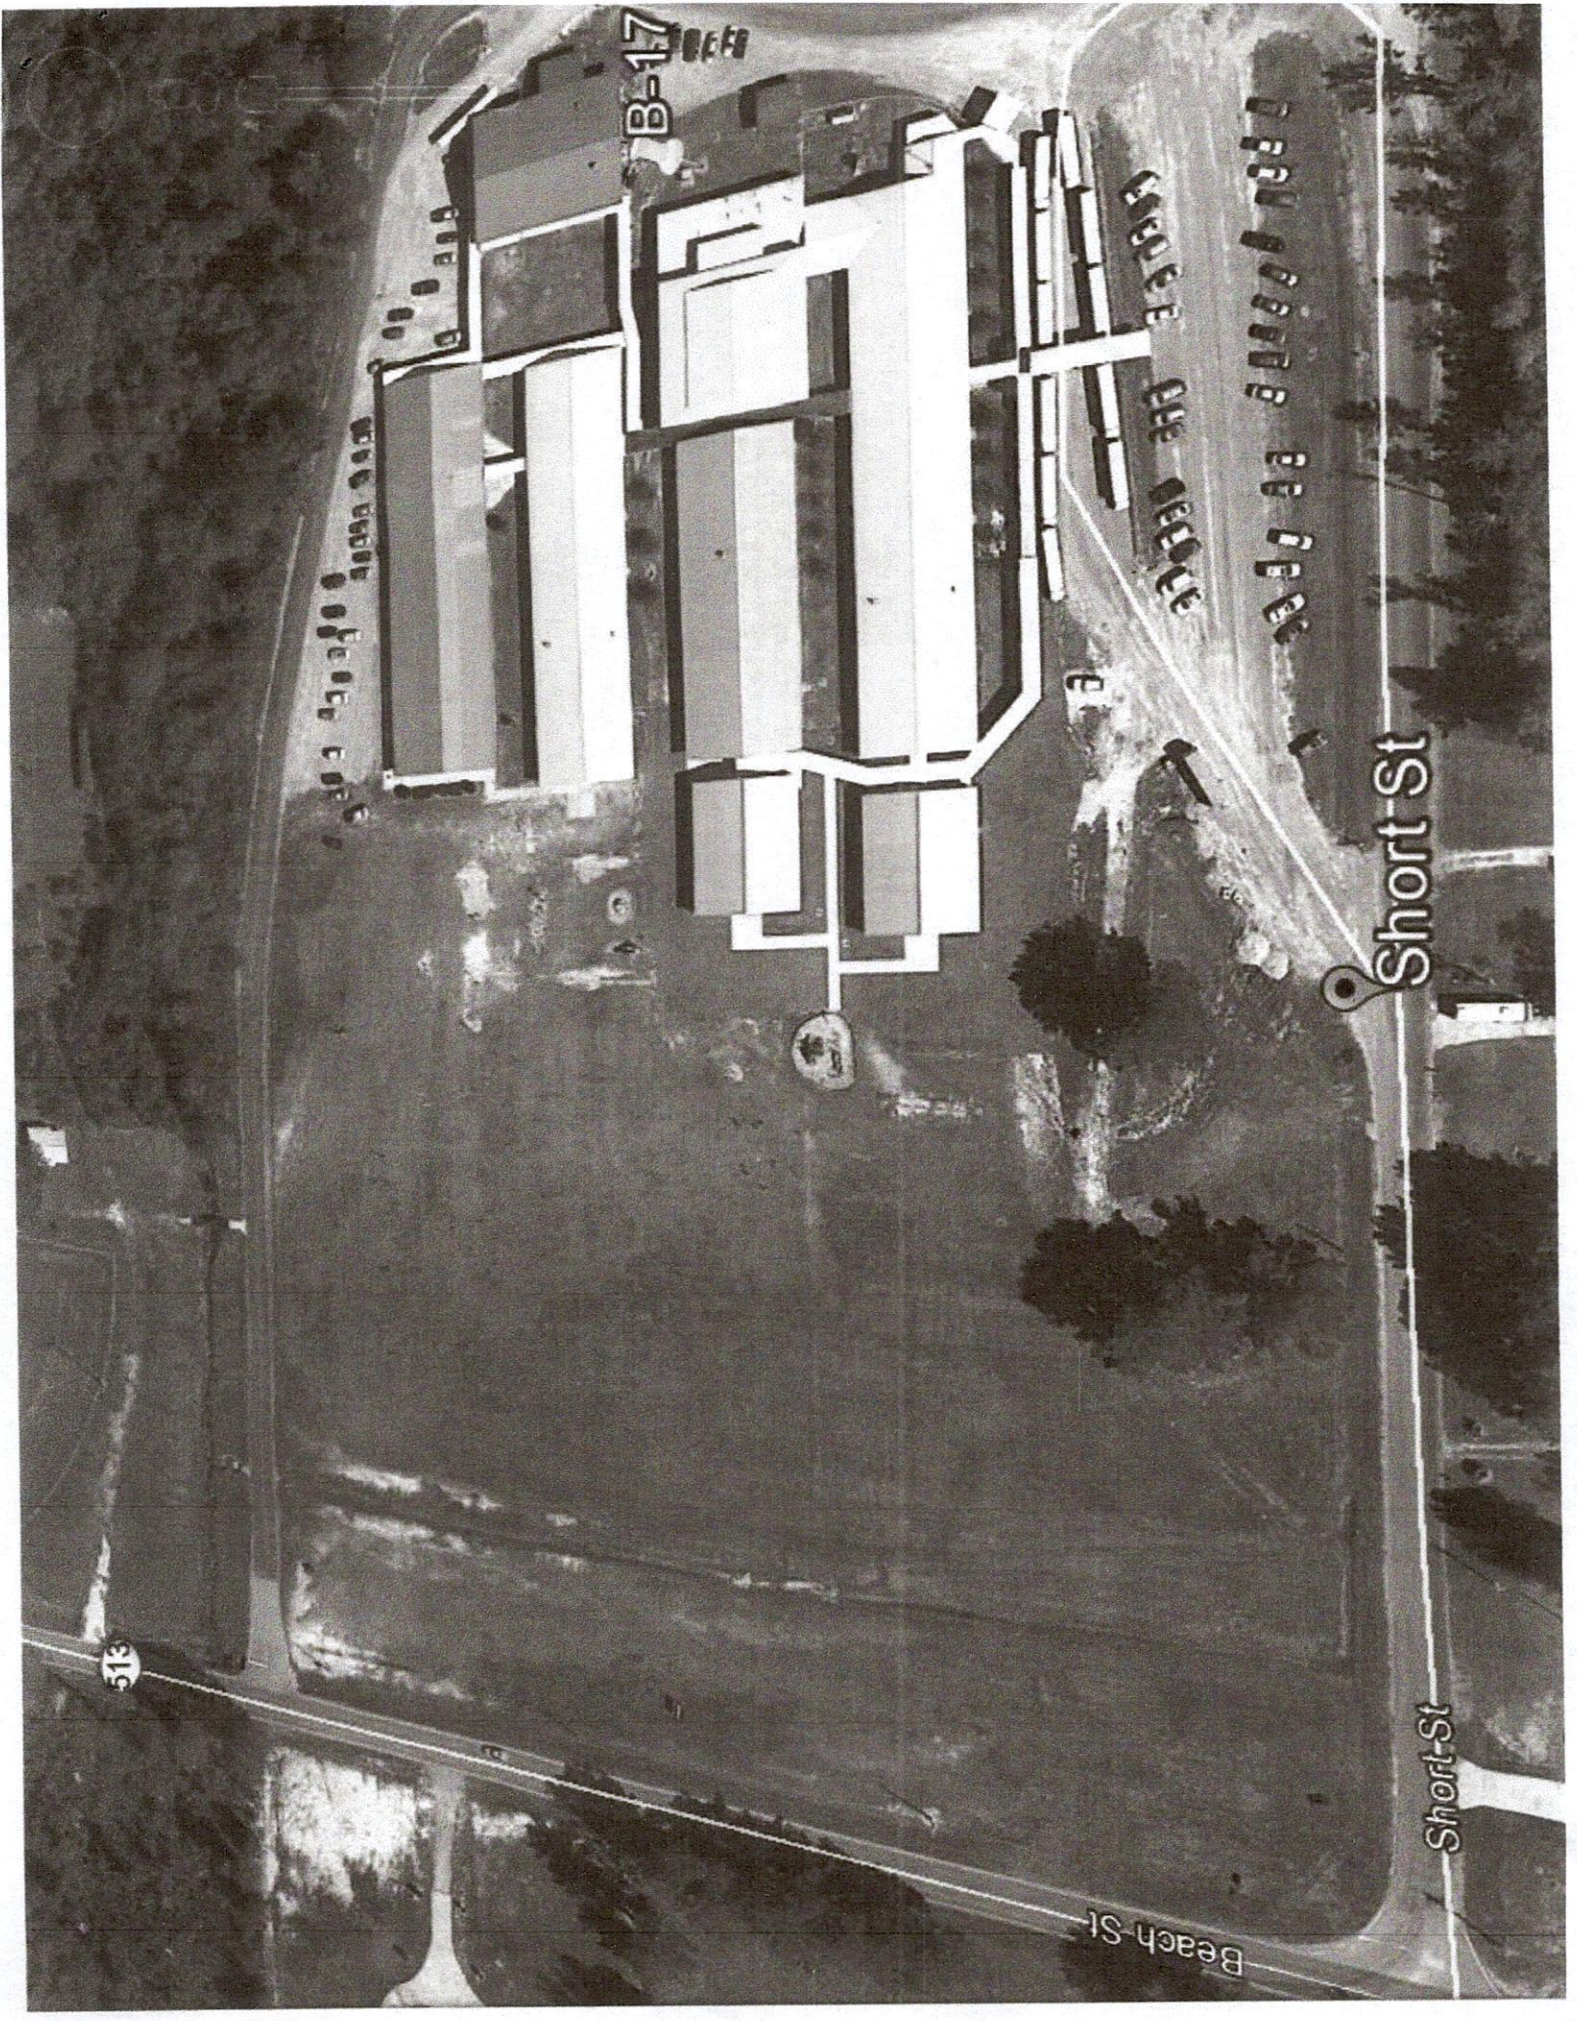

B-17

SHORT ST

SHORT ST

Short St

Short St

Beach St

516