Copiah
L 13
11-66

MISSISSIPPI BOARD OF WATER COMMISSIONERS

WATER WELL DRILLERS LOG

CODED

Date: Nov. 4, 1966, Driller: Burney Water Well Service Inc. County Copiah
(When well drilled) (Name) (Where well is located)

(1) Owner of Land: F. M. Hoagland
(Name)
425 South Extension Hazlehurst
(Address)

(2) Location: NW ¼, NW ¼, Sec. 8 T1N R1W,
6 miles SEast, of Crystal Spgs
(distance) (direction) (Nearest Town)

(3) Topography: Hilly
(Hilly) (Flat) (Level)

(4) Purpose of Well:
(Domestic Irrigation Municipal, Industrial, Other)

Information upon completion of well:

(1) Diameter 8 inches.

(2) Total Depth 242 feet.

(3) Water Level 53 feet below top of ground.

(4) Cased to 215', Size 4",

(5) Screen: Size 4", Length 14'.

(6) Were any formations sealed against pollution?

X yes, ____ no.

If YES depth of formation From surface,

Why To prevent surface polution

Drillers Remarks: Well seal used

Yield in gpm: 600 G. P. H.

Size pump: ½ H. P.

Type power: Electric

Description & Color of Materials Sand, Clay, Red Clay, Shell, etc.	Thickness Feet	Depth Feet
Topsoil	4	4
Gravel	4	8
Pipe clay	7	15
Red sand	23	38
Black marl layers	18	56
Yellow sand	20	76
Pipe clay & sand	6	82
layers iron rock	8	90
Blue & Grey shale	11	101
Hard rock	1	102
Blue shale	13	115
Fine sand layers	5	120
Rock	1	121
Blue Shale	85	206
All sand med.	36	242

CODED

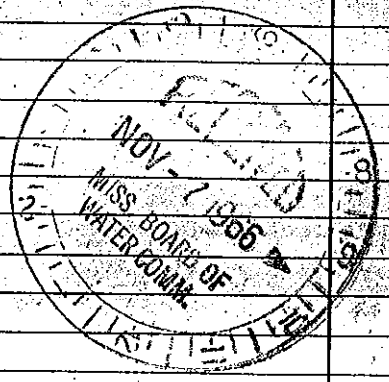

Mail this copy to Board of Water Commissioners 429 Miss. St. Jackson, Miss.