County: Desoto
Permit #:
Driller: Jones W. Mason
Date drilling completed: 8-28-17

STATE WELL REPORT
Part 1
Driller's Log

Mississippi Department of Environmental Quality
Office of Land and Water Resources
P.O. Box 2309
Jackson, MS 39225-2309
(601)961-5210
(601)360-0535 (fax)

For Office Use Only:
Well #: M404
Aquifer:
E-Log #:

State Law requires that this report be prepared by the license holder responsible for the work and filed with the Department at the above address within 30 days of completion of drilling of the well or borehole.

Well Owner Information
(Landowner if borehole is not for a water well)

Owner Name: Trent Rors
Mailing Address: 4920 hwy 305
LOT 1 fox glen subdivision
Hernando MS 38632
City State Zip Code
Telephone No. (901) 508-6207

Well or Borehole Location

Latitude: 34°47'19.49"N Longitude: 89°48'18.75"W
Method of Lat/Long (*check one*): Conventional Survey____, USGS quad____, Hand-held GPS ✓, Survey-grade GPS____
SE ¼ SW NW ¼, Sec 26 T 3S R 6W
7/8 Miles SE of Cockrum
(*Distance*) (*Direction*) (*Nearest Town*)

Well / Borehole Data

Date drilling started: 8-28-17 Date drilling completed: 8-28-17 Hole depth: 180 Hole diameter: 7"
Location of the source of any surface water used for drilling: N/A
Method of dosing and volume of Chlorine used in drilling and development: 50 ppm and greater
Logs run (*circle all applicable*): No log run Electric Gamma Ray Density Sonic Neutron Other: N/A
Name of organization running log(s): N/A
Purpose of borehole (*circle one*): Water Well Geotechnical/Geological Investigation Ground Source Heat Pump Seismic Survey Other (*describe*)

If drilling is not related to water well construction, skip the remainder of this block

Purpose of Well (*circle all applicable*): Home Industrial Public Supply Irrigation Fish Culture
Other (*describe*): N/A
If a flowing well, method of flow regulation: Valve N/A Other (*describe*) N/A
Static Water Level: 115 feet [above or below] land surface (*circle one*) Date measured: 8-28-17
Method of measurement (*circle one*): Steel tape Electric tape Air line Other (*describe*): Stray / weight
Well depth: 180 Well grouted to a depth of: 50 feet Type of grout (*circle one*): Neat Cement Bentonite Mix
Casing length: 170 feet Casing diameter: 4 inches Type of casing: PVC
Screen length: 10 feet Screen diameter: 4 inches Type of screen: PVC
Screen slot size: .010 inches Setting depth: From 170 feet to 180 feet
Type of completion (*circle all applicable*): Gravel packed Underreamed Open hole Natural Development
Other (*describe*): N/A
Top of lap pipe or reduction in casing: N/A feet

If telescoped or more than one screen, describe on next page

RECEIVED OCT 02 2017 BY OLWR

Form: OLWR-SWR-1A (4/13)

County: DeSoto

Permit #:

For Office Use Only:

Well #: M404

The sketch below only required for water wells

If well telescopes, show depths on sketch.

Ground Level

If more than one screen, show location of each on sketch

Description of formations encountered must be provided for all wells and boreholes, unless specifically exempted by regulations

Description of Formations Encountered	From (*depth*)	To (*depth*)
clay dirt	Ground level	15
gravel	15	20
white sand	20	100
white clay	100	120
white sand	120	180

Sketch the property layout and include the following:

1) the well location
2) any permanent structures on the property that may aid in locating the well
3) any roads, power lines, or other items that may aid in locating the property and the well
4) north arrow

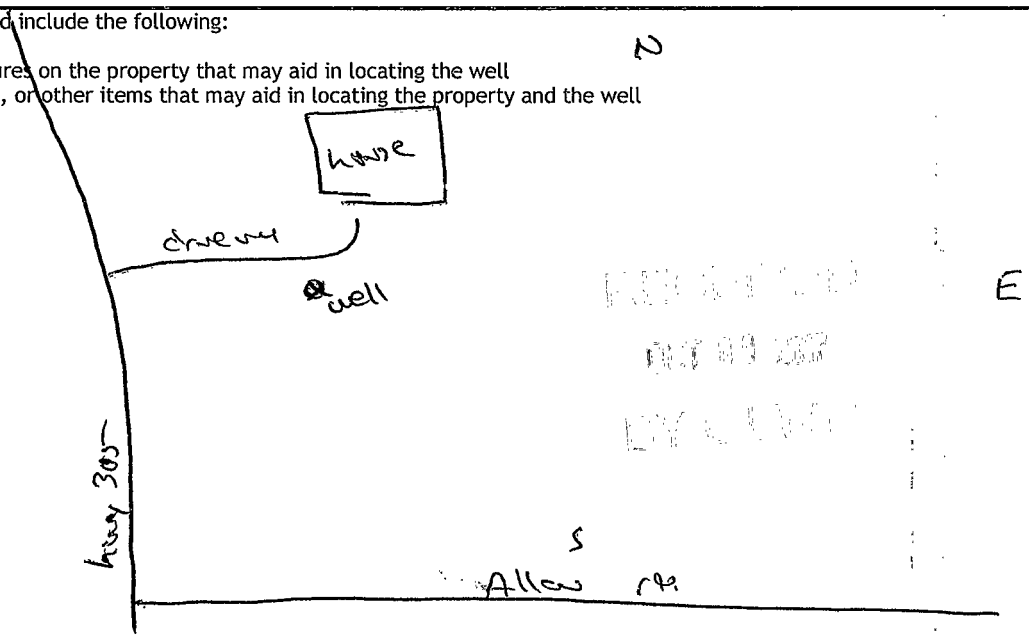

Landowner Name: Trent Ross

I HEREBY CERTIFY that the well/borehole was drilled, constructed, and completed in accordance with all applicable requirements of the Mississippi Department of Environmental Quality and the Mississippi Department of Health regulations, if applicable, and state laws.

Print Name of Responsible Licensee and License No.	Date	Signature of Licensee
Jared W. Mason 0620	9-26-17	Jared W. Mason

Form: OLWR-SWR-1A (4/13)

STATE WELL REPORT

Part 2

Pump Installer's Completion Report

Mississippi Department of Environmental Quality
Office of Land and Water Resources
P.O. Box 2309
Jackson, MS 39225-2309
(601)961-5210
(601) 360-0535 (fax)

County: Desoto
Permit #:
Driller: Jones W. Mason
Date completed: 8-28-17
Copy information from block on Part 1

For Office Use Only:
Well #: M404
Aquifer:

This part of the report must be completed by a licensed water well contractor or a licensed pump installer. A copy of Part 1 of the report must be attached and both parts filed with the Department at the above address within 30 days of well completion.

Well Owner Information

Owner Name: Trent Ross
Mailing Address: 4920 hwy 305
LOT 1 fox glen sub.
Hernando MS 38632
City State Zip Code
Telephone No. (901) 508-6207

Well Location

Latitude: 34°47'19.49"N Longitude: 89°48'18.35"W
Method of Lat/Long (*check one*): Conventional Survey____, USGS quad____, Hand-held GPS ✓, Survey-grade GPS____
SE ¼ ~~SW~~ NW ¼, Sec 26 T 3S R 6W
2/8 Miles SE of Cockrum
(Distance) (Direction) (Nearest Town)

Pump Type (*circle one*)

(Submersible) Turbine Air Lift Centrifugal Flowing Well Jet Piston Rotary Other (*describe*):
Date Pump Installed: 8-28-17 Rated Pump Capacity: 10 Gallons Per Minute
Is This Pump (*circle one*): (New) Repaired Replacement

Power Type (*circle one*)

(Electric) Diesel Gasoline Natural Gas Tractor PTO Windmill Other (*describe*):
Horse Power Rating of Motor: 3/4 Setting Depth: 140 feet Number of Stages: 8

Pump Test Data for Non Flowing Well

Date Well Tested: 8-28-17 Duration of Pump Test (*minimum 4 hours*): 24 hours
Static Water Level (A): 115 Feet Below Land Surface Pumping Water Level (B): N/A Feet Below Land Surface
Drawdown [(B) - (A)]: N/A Feet Below Land Surface Test Pumping Rate: 10 Gallons Per Minute
Method of measurement (*circle one*): Steel tape Electric tape Air line Other (*describe*): String / weight

Pump Test Data for Flowing Well

Measured shut in head: N/A feet.
Well yielded 10 GPM with a drawdown of N/A feet after 24 hours of pumping

Meter Installation

Meter Manufacturer: N/A Meter Serial Number: N/A
Meter Model Number/Name: N/A Type of Meter: N/A
Totalizer Register Unit and Multiplier Factor (AF x .001, gal x 1000, etc): N/A
Installation Date: N/A Meter installed by: N/A
Is This Meter (*circle one*): New Repaired Replacement

Important: By submitting the above information you are certifying that this meter was installed to manufacturer standards. For agricultural wells, a list of approved meters is on the MDEQ website.

I HEREBY CERTIFY that the above statements are true to the best of my knowledge.

Jones W. Mason 0-620 — Print Name of Pump Installer and License No. (*if applicable*)
9-26-17 — Date
Jones W. Mason — Signature of Pump Installer

Form: OLWR-SWR-1B (4/13)