

FORREST MISSISSIPPI BOARD OF WATER COMMISSIONERS

B73 ②  
8-28-61

WATER WELL DRILLERS LOG

Date: 8-28, 1961, Driller: Hermon Park County Forrest  
(Name)

(1) Owner of Land:	Description & Color of Materials Sand, Clay, Red Clay, Shell, etc.	Thick- ness Feet	Dept' Feet
<u>Exel Breland</u> (Name)	<u>Gravel</u>	<u>20</u>	<u>20</u>
<u>Rt. 7 Hattestung</u> (Address)	<u>Sand</u>	<u>38</u>	<u>58</u>
(2) Location: <u>3</u> <u>SW 13W</u> ¼, ¼, Sec. <u>3</u> T. <u>R</u>			
<u>5</u> miles <u>North</u> of <u>Hattestung</u> (distance) (direction) (Nearest Town)			
(3) Topography: <u>Hilly</u> (Hilly) (Flat) (Level)			
(4) Purpose of Well: <u>Domestic</u> (Domestic Irrigation Municipal, Industrial, Other)			


Information upon completion of well:

- (1) Diameter: 2 inches.
- (2) Total Depth: 58 feet.
- (3) Water Level: 31 feet below top of ground.
- (4) Cased to: 58, Size 2"
- (5) Screen: Size 2", Length 51
- (6) Were any formations sealed against pollution?  
\_\_\_\_\_ yes, 1 no.

If YES depth of formation \_\_\_\_\_

Why \_\_\_\_\_

Drillers Remarks: \_\_\_\_\_

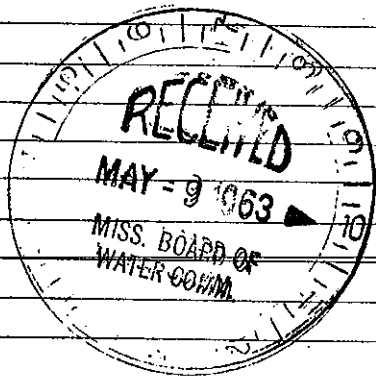

58

49

Well No.

(Use Back Side)

Mail this copy to Board of Water Commissioners 429 Miss. St. Jackson, Mis